

LEGEND

- Excavation or embankment slope
- Riprap except Sta. 89+00 to Sta. 90+40 on Genesee River which is precast concrete blocks.
- Fence
- Railroad
- Pole line, power or telephone
- ΔPI Point of Intersection of tangents
- CMP Corrugated Metal pipe
- Inv. E.L. Invert Elevation
- LB Left Bank
- M.H. Manhole
- PC Point of Curvature
- PP Power Pole
- PT Point of Tangency
- RB Right Bank
- TP Telephone Pole
- VTP Vitriified Tile Pipe


GENERAL NOTES:
 Elevations are in feet and tenths above mean sea level, United States Coast and Geodetic Survey Datum (Based on B.M. described in specification).

All stationing is along centerline of the channel, unless otherwise indicated.
 All sections are looking downstream, except as noted.
 Coordinates and curve data for new channel centerline are indicated on the drawings. Coordinates for survey traverse points are indicated on drawings.

Where channel grade is above the existing channel bottom, fill will not be required, unless otherwise specified.

INDEX OF DRAWINGS	
DWG. NO.	TITLE
76-WEL-	GENERAL
1/1	GENERAL PLAN AND INDEX
1/2	PLAN, PROFILE AND SECTIONS-STA.22+60 TO STA.32+97.74
1/3	PLAN AND PROFILE-STA.82+20 TO STA.103+00
1/4	SECTIONS AND DETAILS
1/5	HYDROGRAPHS AND BATING CURVES
89-WEL-	GENESEE RIVER
1/3	REFERENCE DRAWING-SUBSURFACE EXPLORATIONS
2/1	REFERENCE DRAWING-PLAN, PROFILE AND SECTIONS
2/2	REFERENCE DRAWING-PLAN, PROFILE AND SECTIONS

AS CONSTRUCTED	
SUBMITTED: <i>[Signature]</i> CHIEF, CONSTRUCTION-OPERATIONS DIVISION	APPROVED: <i>[Signature]</i> COL., C. E. DISTRICT ENGINEER
REVISION	DATE
1	4/19/76
REVISED ACCORDING TO AMENDMENT NO. 0002	
U.S. ARMY ENGINEER DISTRICT, BUFFALO CORPS OF ENGINEERS BUFFALO, NEW YORK 14207	
LOCAL FLOOD PROTECTION WELLSVILLE, NEW YORK GENERAL GENERAL PLAN AND INDEX	
DRAWN BY: W.F.S. DESIGNED BY: J.A.K. CHECKED BY: E.J.G. SUBMITTED BY: <i>[Signature]</i> APPROVAL RECOMMENDED: <i>[Signature]</i> CHIEF, ENGINEERING DIVISION	
TO ACCOMPANY SPECIFICATIONS SERIAL NO. DACW 49 78 B 0015	
DRAWING NUMBER 76-WEL-1/1 SHEET 1 OF 5	

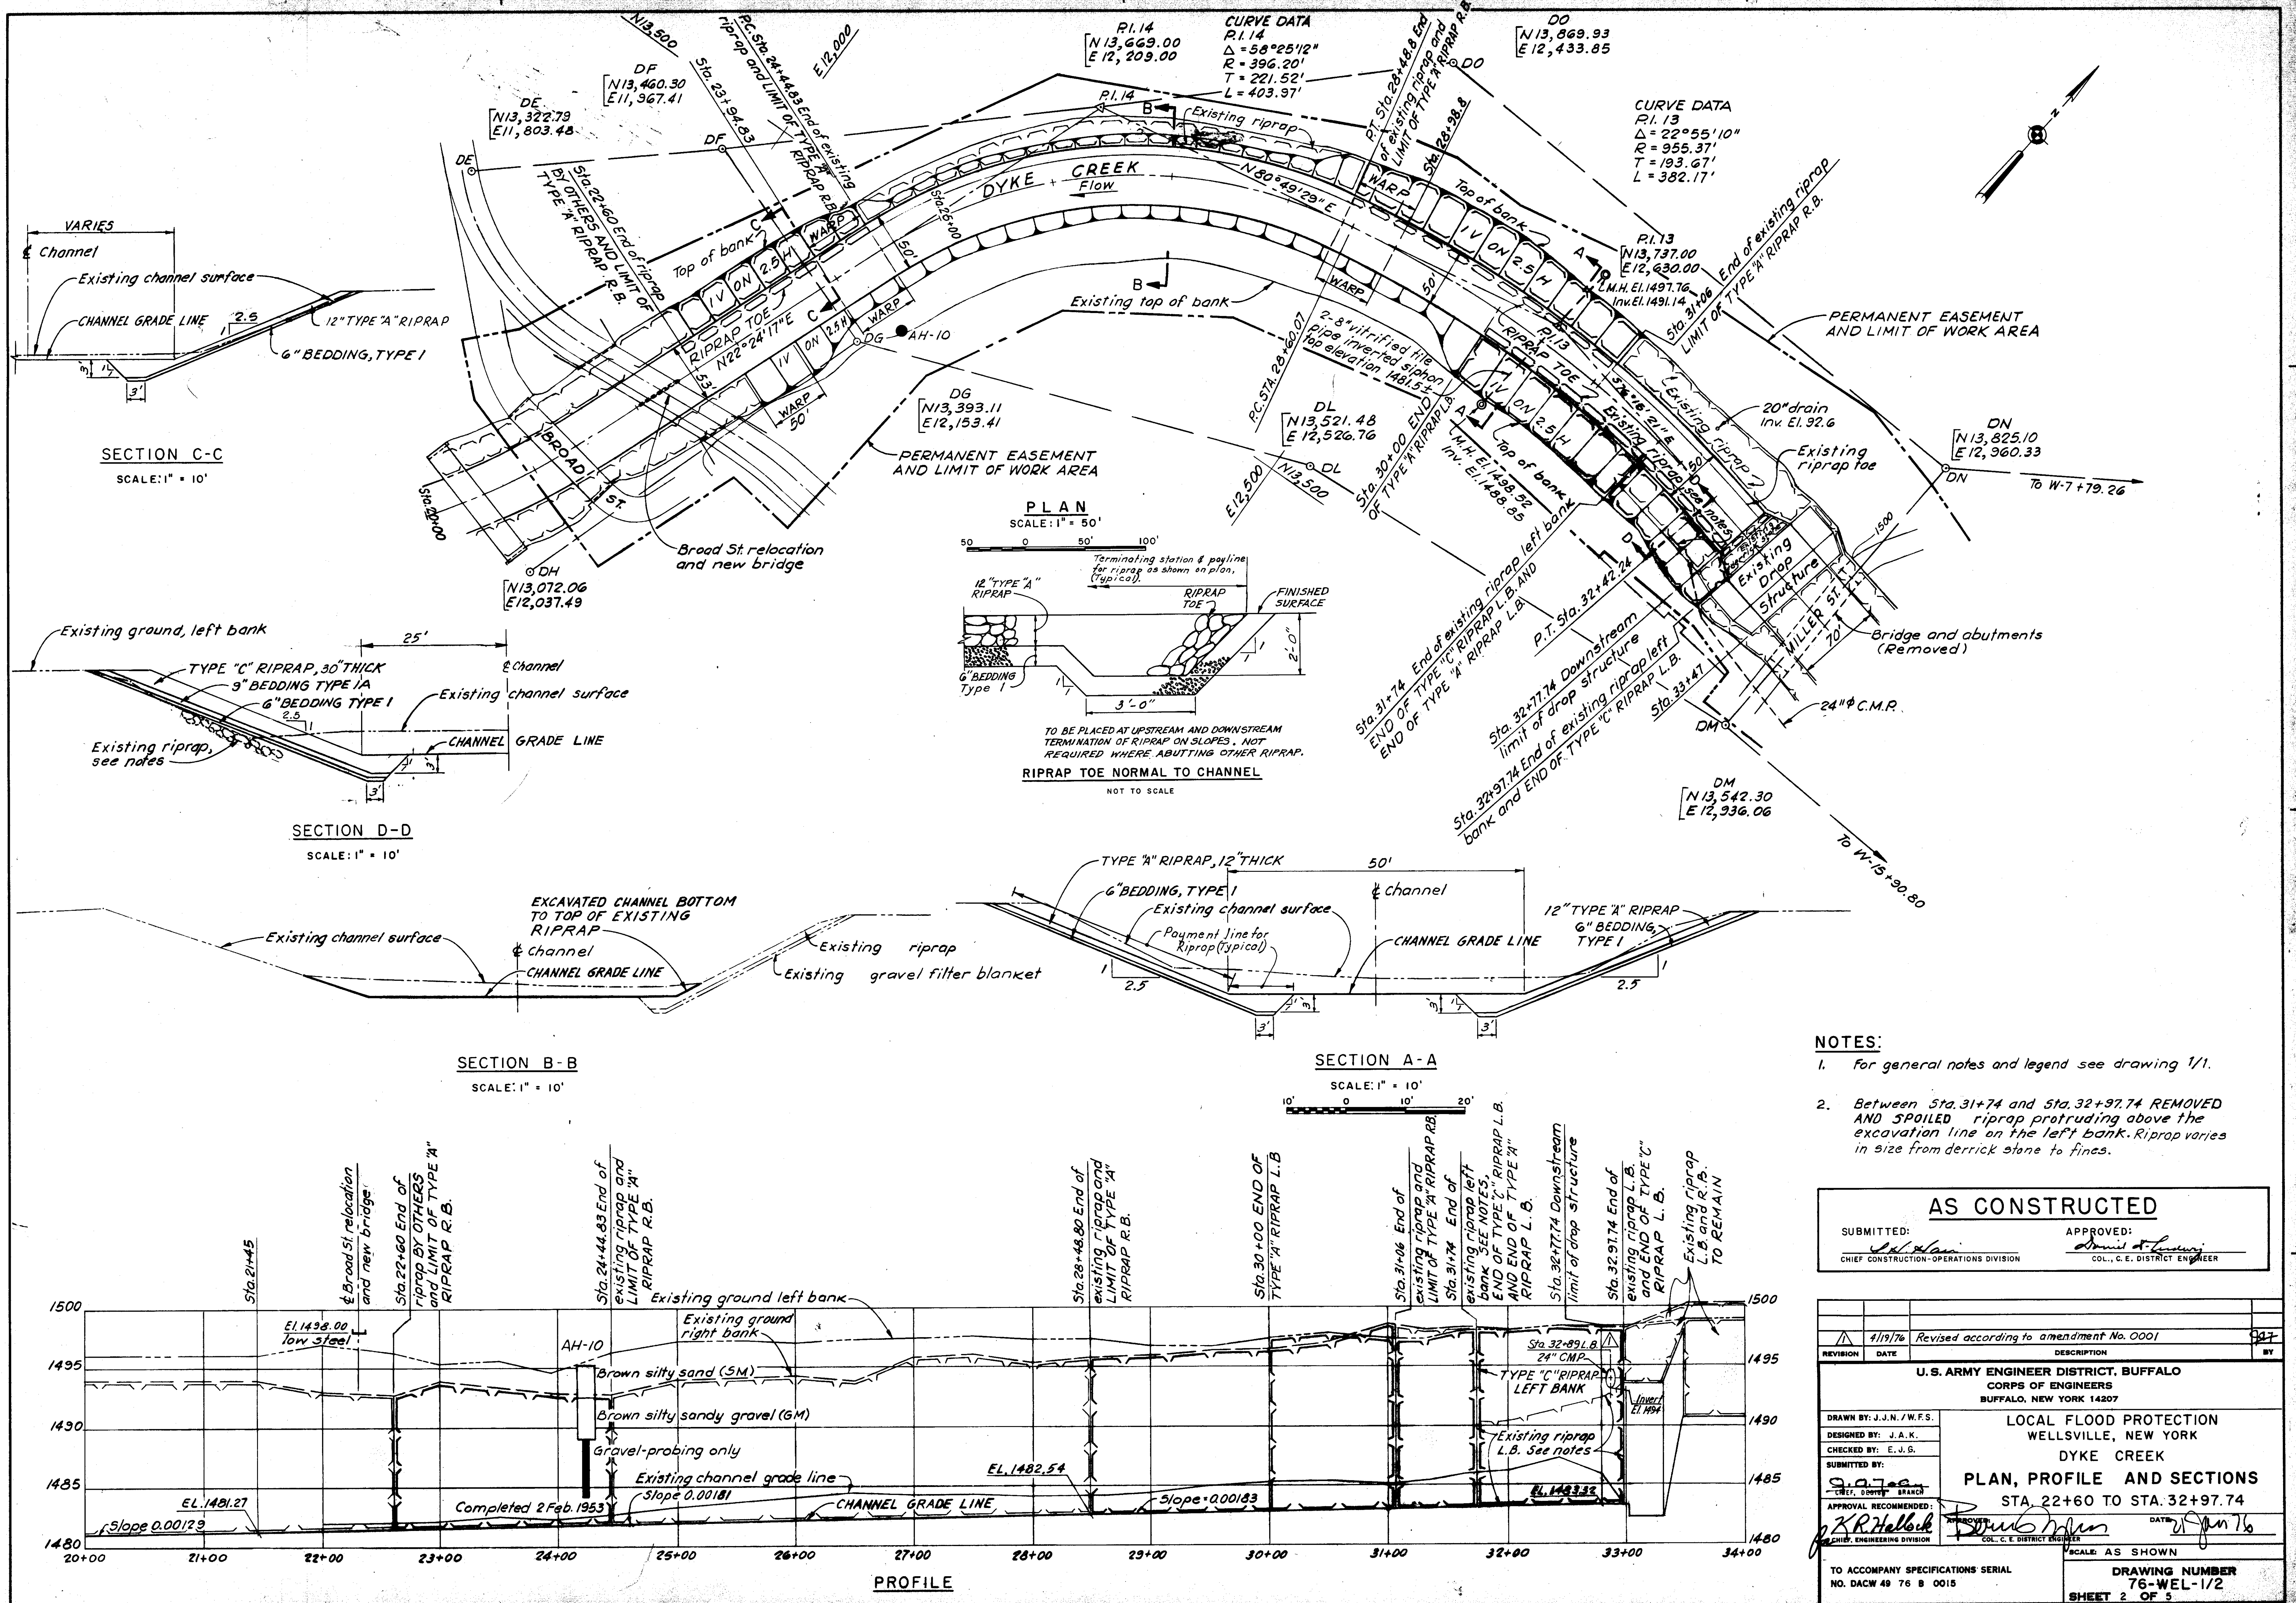

NOTES:

1. Channel bottom and side slopes from Sta. 94+00 to the existing weir at Sta. 102+87.25 were constructed to the lines and grades shown. Localized erosion and shoaling which had occurred in this area was restored in accordance with the specifications.

2. Existing contours and topography shown reflect August 1974 conditions which have been subject to change due to continuing erosion and shoaling.

3. For existing conditions of 24" C.M.R., see reference drawing 189-WEL-2/1.

4. For boring locations and boring logs, see reference drawings 189-WEL-2/1 and 1/3. Borings not shown on Dwg. 2/1 are located outside the work area.

5. For profile of existing dike at Sta. 102+87.25, see reference drawing 189-WEL-2/2.


NOTE:

The bench mark established by the Government is described as follows: PTS 29 (U.S.G.S.) at Wellsville, Allegheny County, at the Municipal Building, at the intersection of North Main and Jefferson Streets, 43 feet east of the center line of North Main Street, 39 feet north of the center line of Jefferson Street, in a column pedestal at the left of the entrance 5 feet west of the center of the entrance.

NOTE: (Cont'd.)

and about 3.5 feet higher than the street. A United States Geological Survey standard disk, stamped "1516 D.P.T.S. 29 1923" and set vertically. Elevation 1517.412 feet.

CURVE DATA	CURVE DATA	CURVE DATA
P.I. 1A	P.I. 1B	P.I. 1C
$\Delta = 39^{\circ}00'00''$	$\Delta = 48^{\circ}00'00''$	$\Delta = 41^{\circ}00'00''$
$R = 818.51'$	$R = 572.96'$	$R = 818.51'$
$T = 289.85'$	$T = 255.10'$	$T = 306.03'$
$L = 557.14'$	$L = 480.00'$	$L = 585.71'$

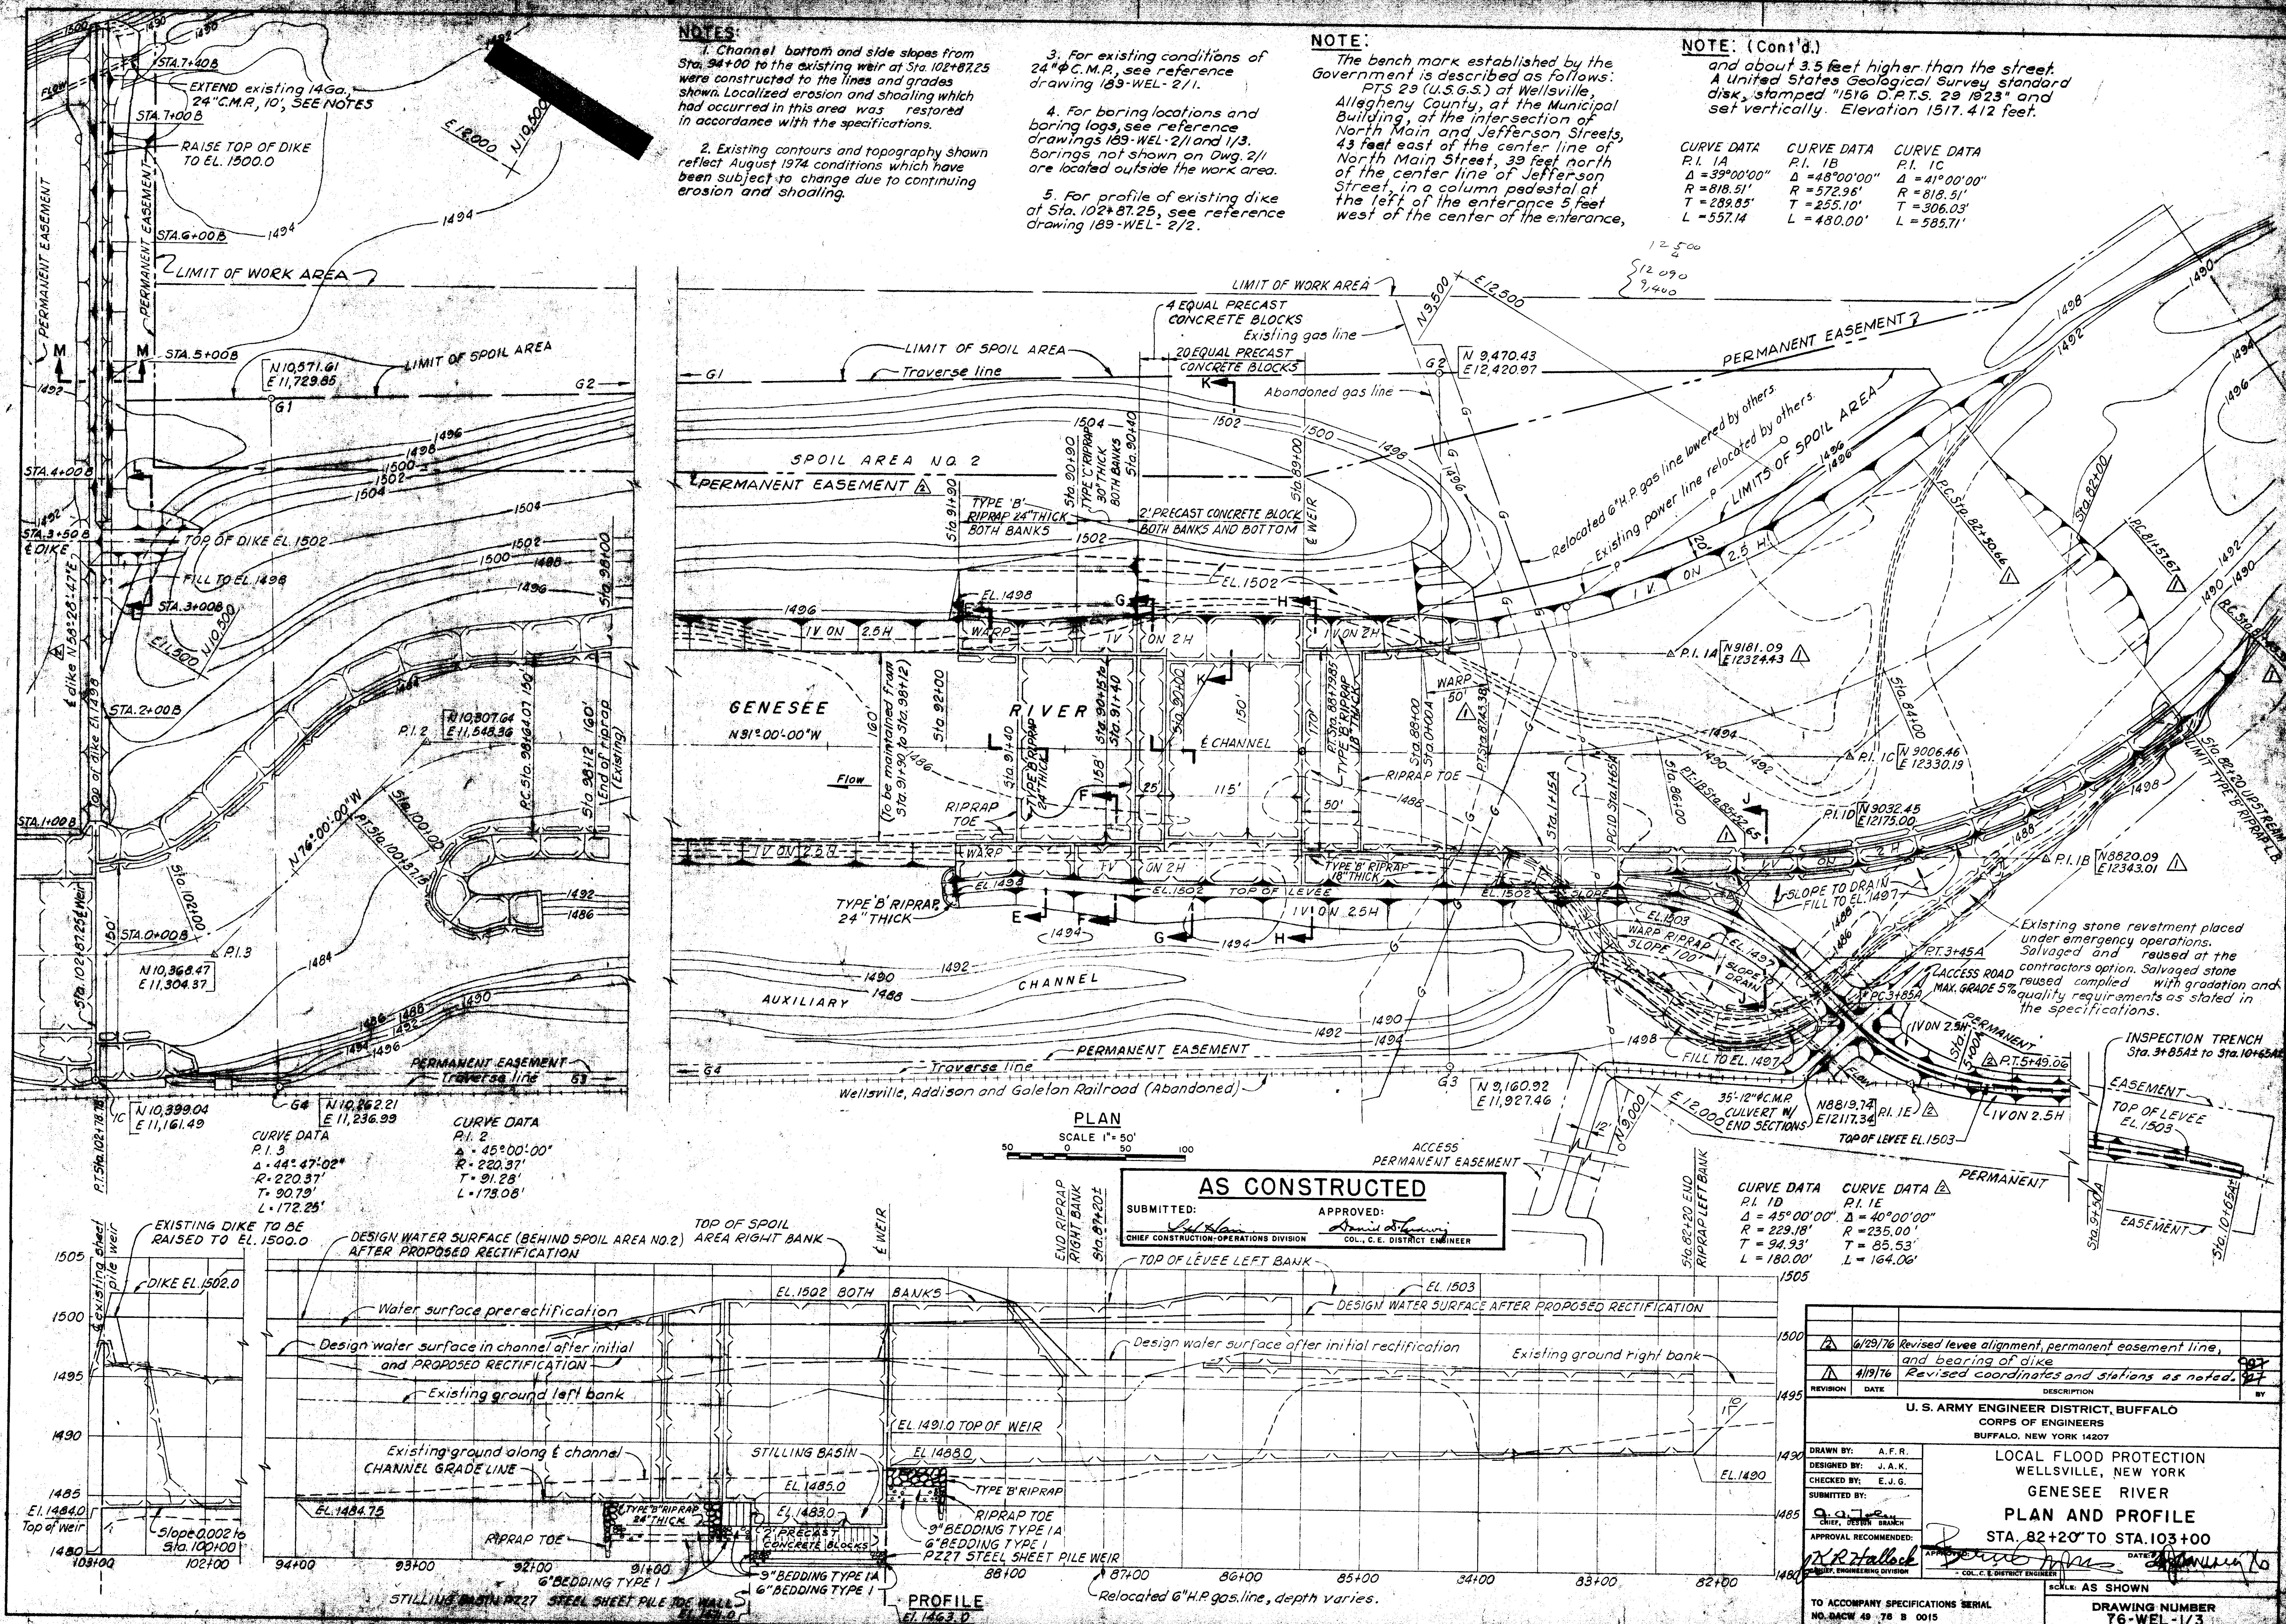

PLAN

SCALE 1" = 50'

AS CONSTRUCTED

SUBMITTED: *[Signature]* APPROVED: *[Signature]*
CHIEF CONSTRUCTION OPERATIONS DIVISION COL. C.E. DISTRICT ENGINEER

CURVE DATA	CURVE DATA
P.I. 1D	P.I. 1E
$\Delta = 45^{\circ}00'00''$	$\Delta = 40^{\circ}00'00''$
$R = 229.18'$	$R = 235.00'$
$T = 94.93'$	$T = 85.53'$
$L = 180.00'$	$L = 164.06'$

CURVE DATA	CURVE DATA
P.I. 2	P.I. 3
$\Delta = 45^{\circ}00'00''$	$\Delta = 44^{\circ}47'02''$
$R = 220.37'$	$R = 220.37'$
$T = 91.28'$	$T = 90.79'$
$L = 178.08'$	$L = 172.25'$

DESIGN WATER SURFACE (BEHIND SPOIL AREA NO. 2) AFTER PROPOSED RECTIFICATION

Water surface prerectification

Design water surface in channel after initial and proposed rectification

Existing ground left bank

Existing ground along E channel CHANNEL GRADE LINE

STILLING BASIN

EL 1484.75

STILLING BASIN 22' STEEL SHEET PILE WEIR

6" BEDDING TYPE I

6" BEDDING TYPE I

6" BEDDING TYPE I

TOP OF SPOIL AREA RIGHT BANK

EL 1502 BOTH BANKS

EL 1491.0 TOP OF WEIR

EL 1488.0

EL 1485.0

EL 1483.0

EL 1480.0

EL 1477.0

EL 1474.0

EL 1471.0

EL 1468.0

EL 1465.0

TOP OF LEVEE LEFT BANK

EL 1503

DESIGN WATER SURFACE AFTER PROPOSED RECTIFICATION

Existing ground right bank

EL 1490

EL 1485

EL 1480

EL 490


EL 485

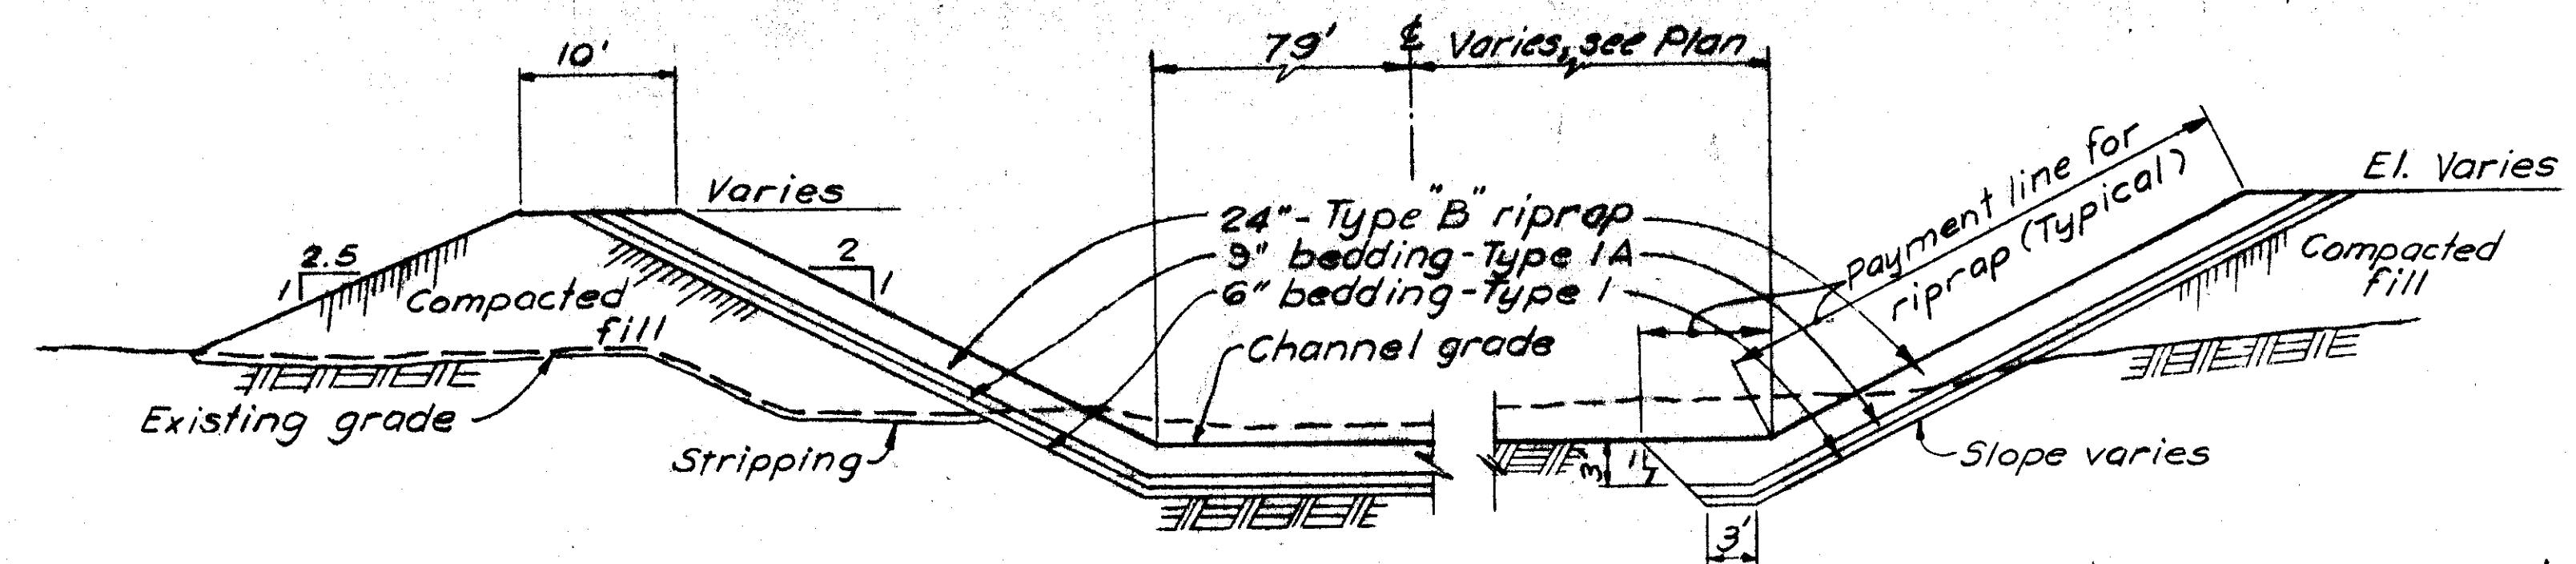


SECTION E-E
SCALE: 1"=10'

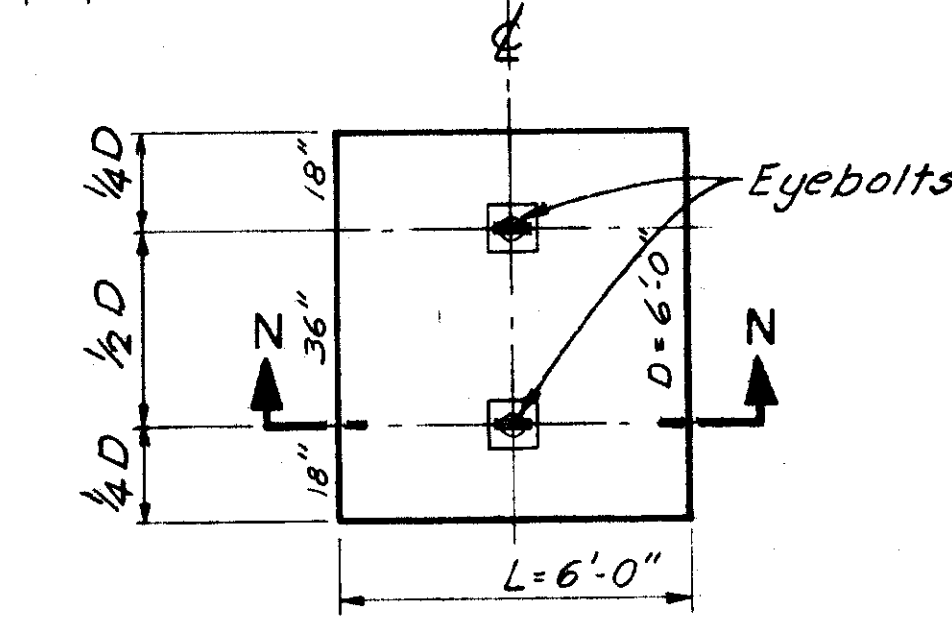


PLAN (TYPICAL)
PRECAST CONCRETE BLOCKS
NOT TO SCALE
(SEE NOTES)

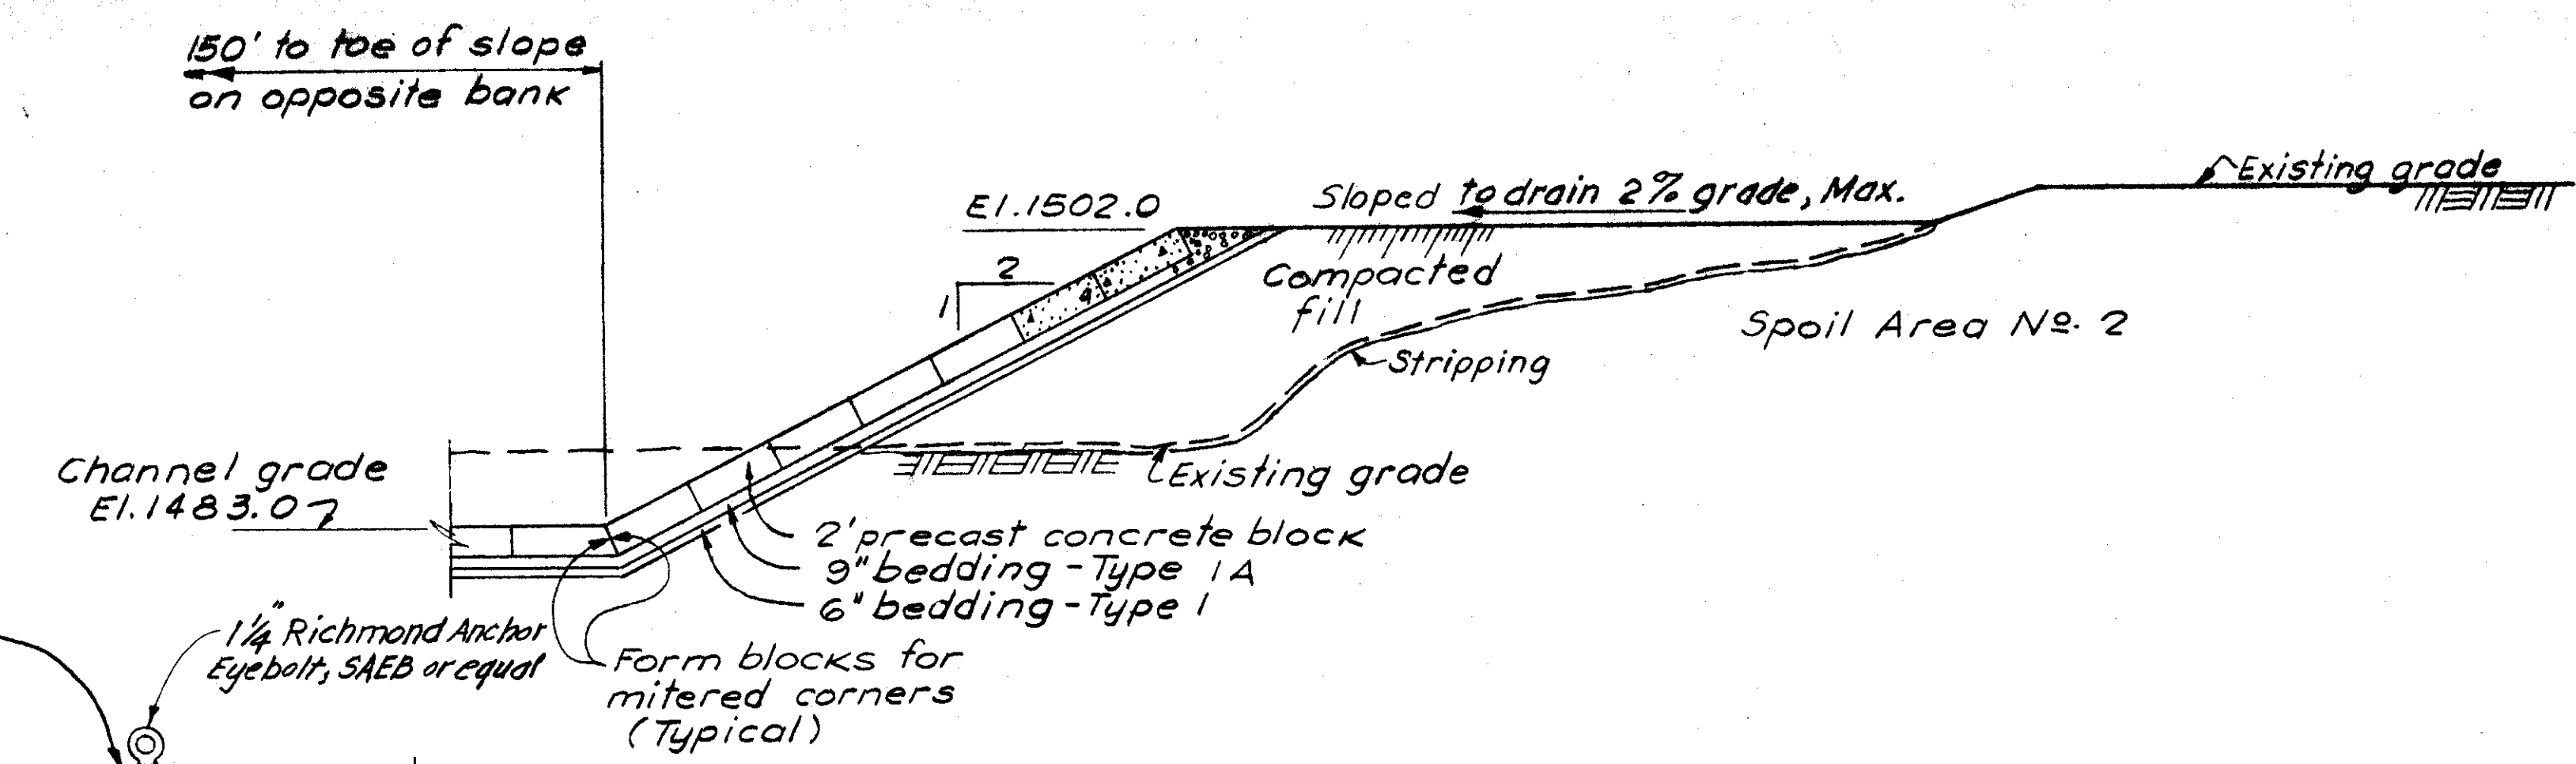


SECTION K-K
SCALE: 1"=10'

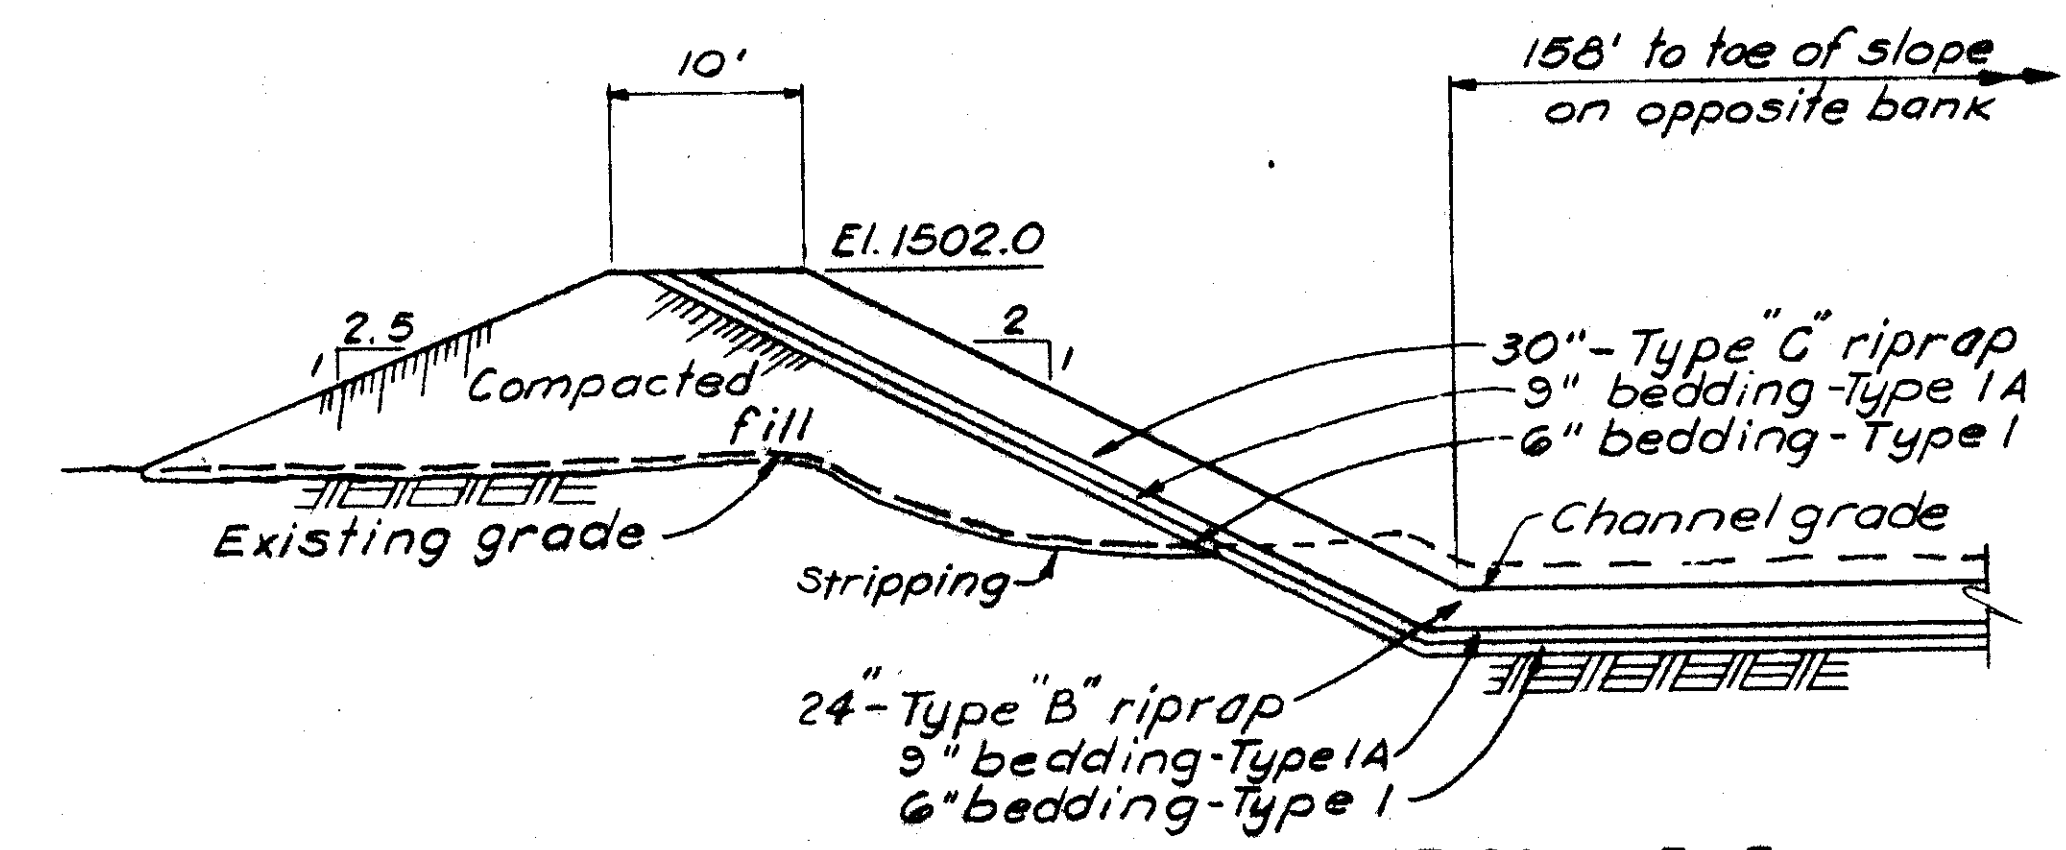


SECTION F-F
SCALE: 1"=10'

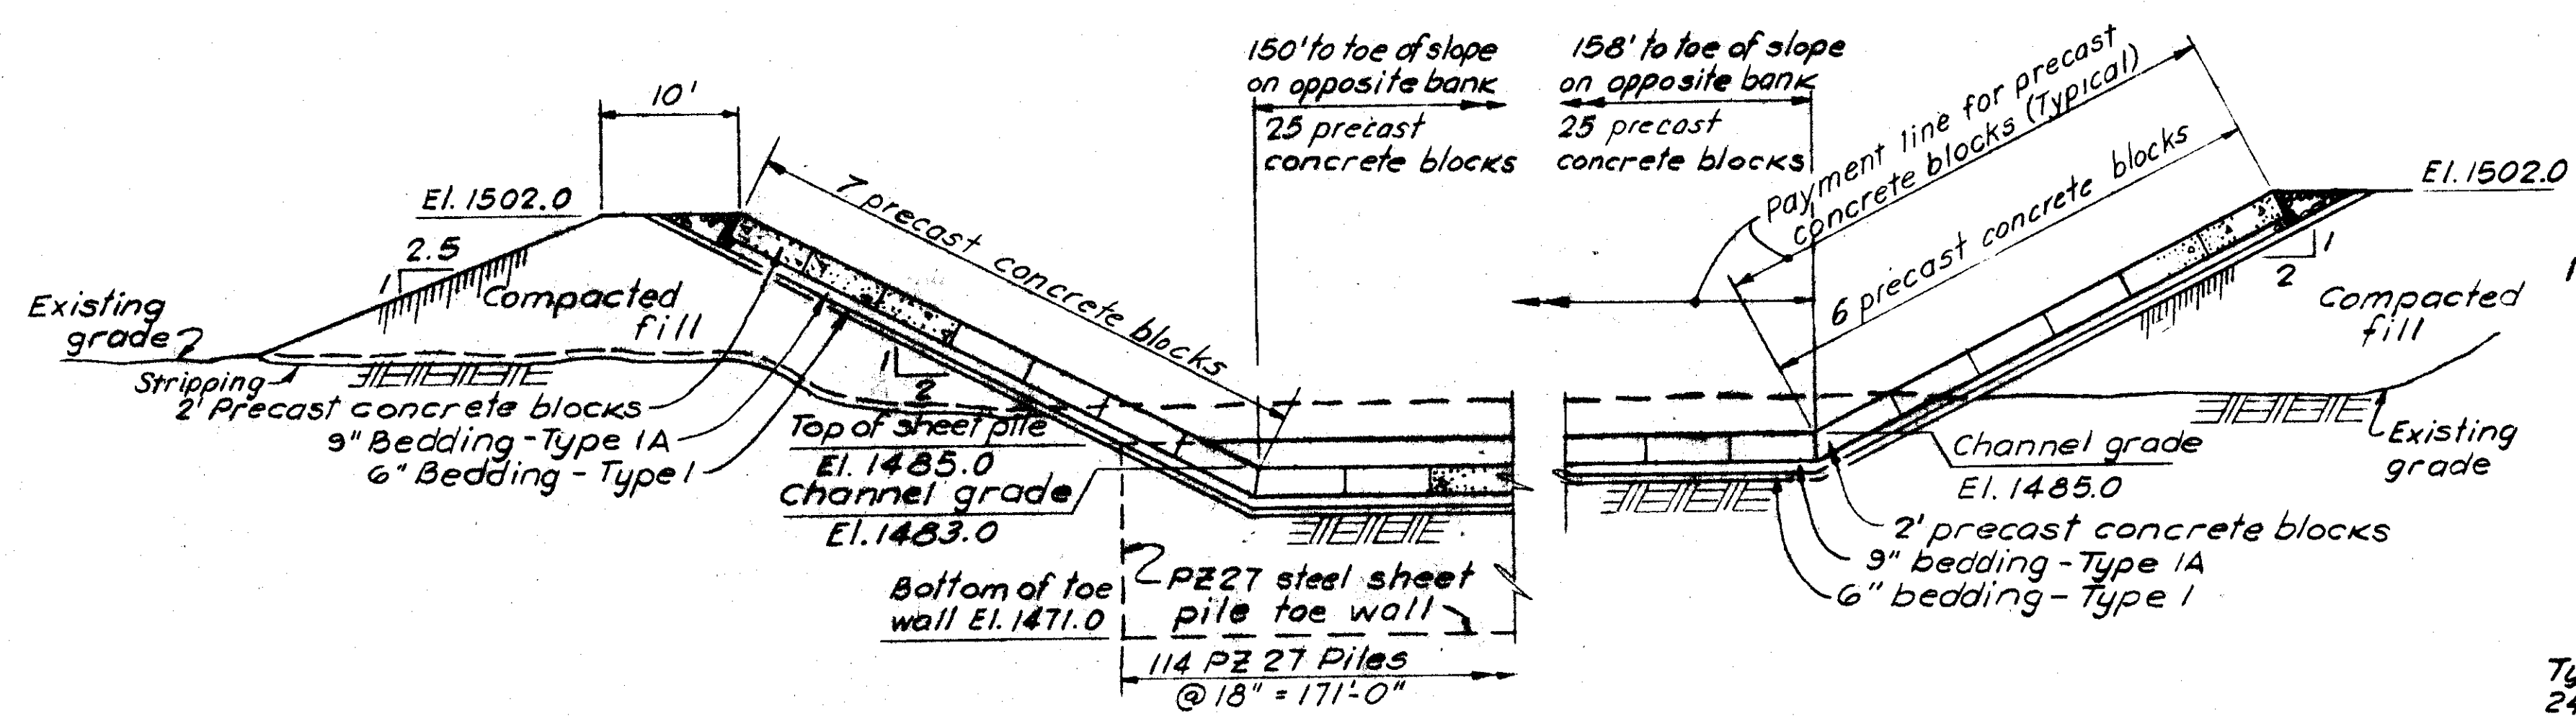


SECTION G-G
SCALE: 1"=10'

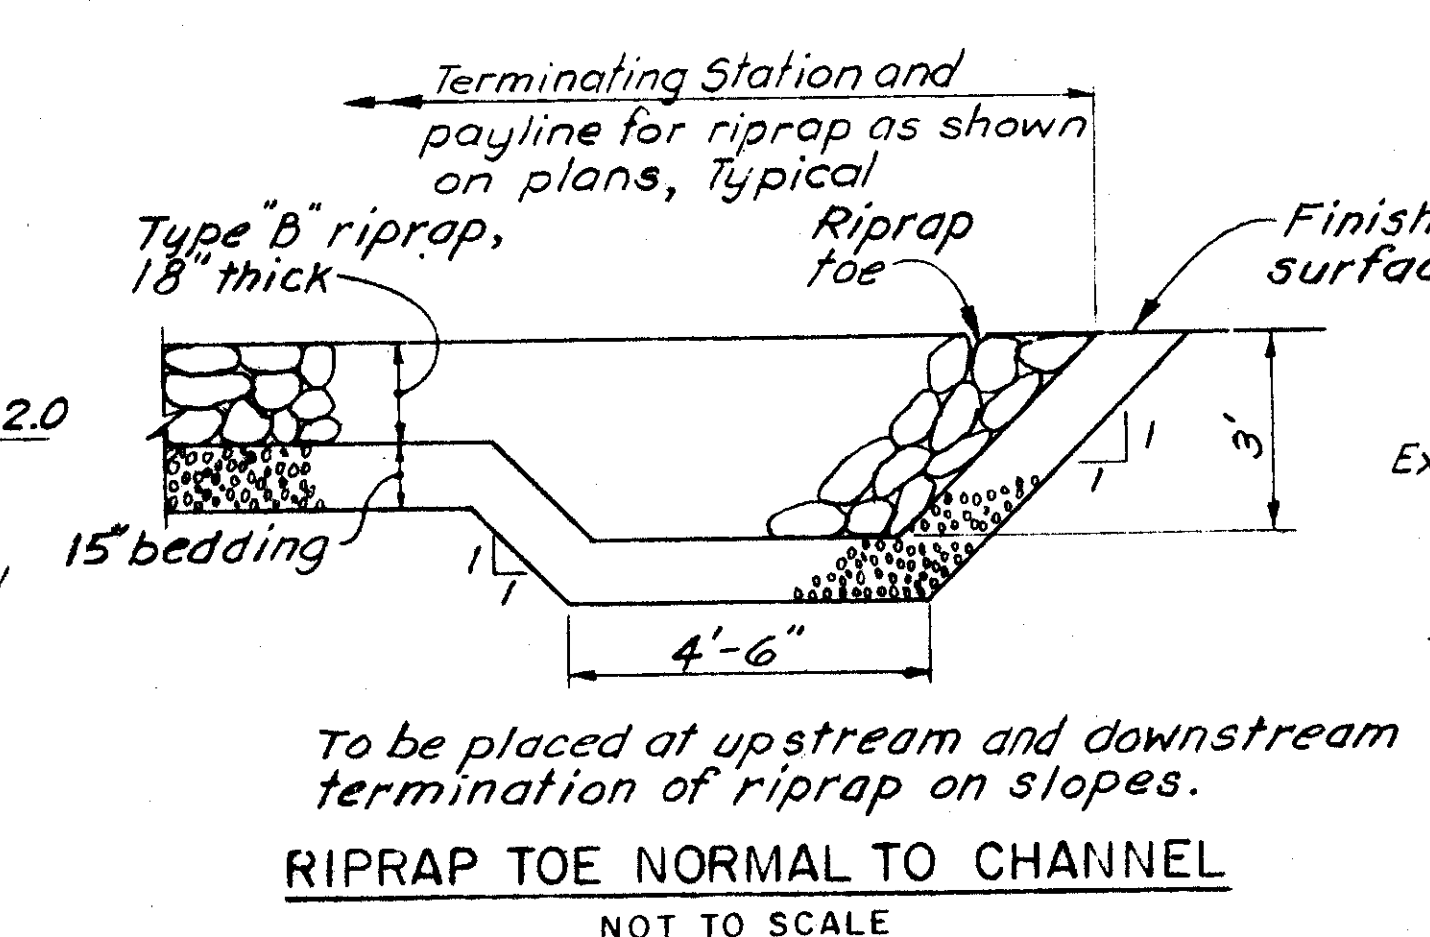


DETAIL "A"
NOT TO SCALE

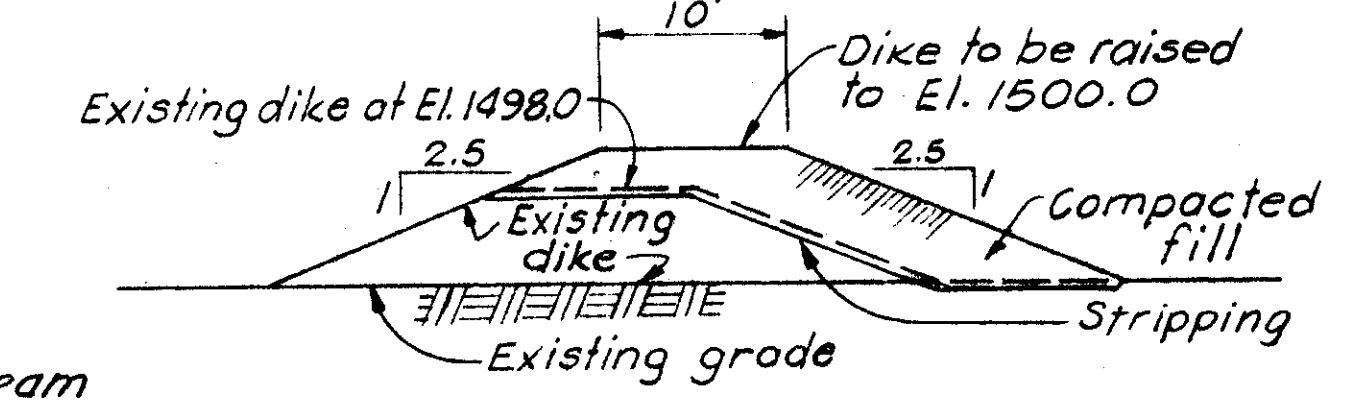


SECTION M-M
SCALE: 1"=10'

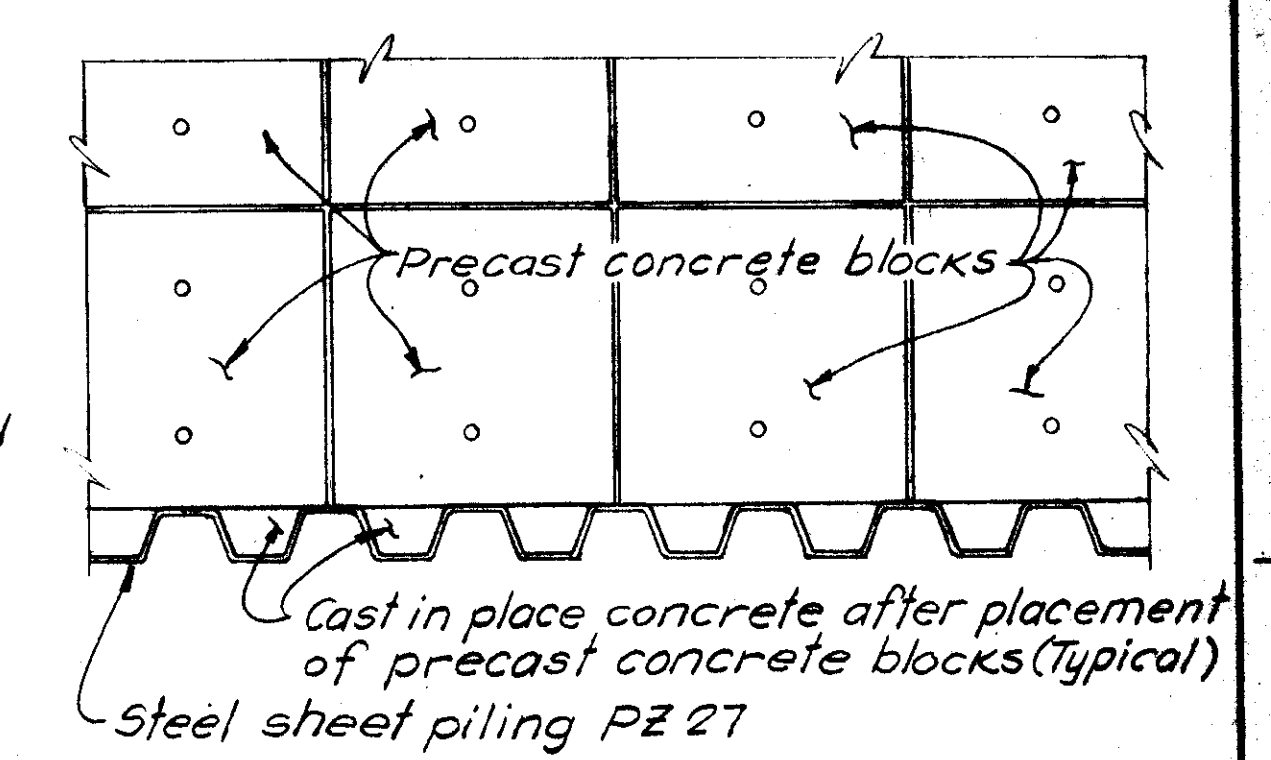


PLAN
PRECAST CONCRETE BLOCKS
ABUTTING STEEL SHEET PILE WALLS
NOT TO SCALE

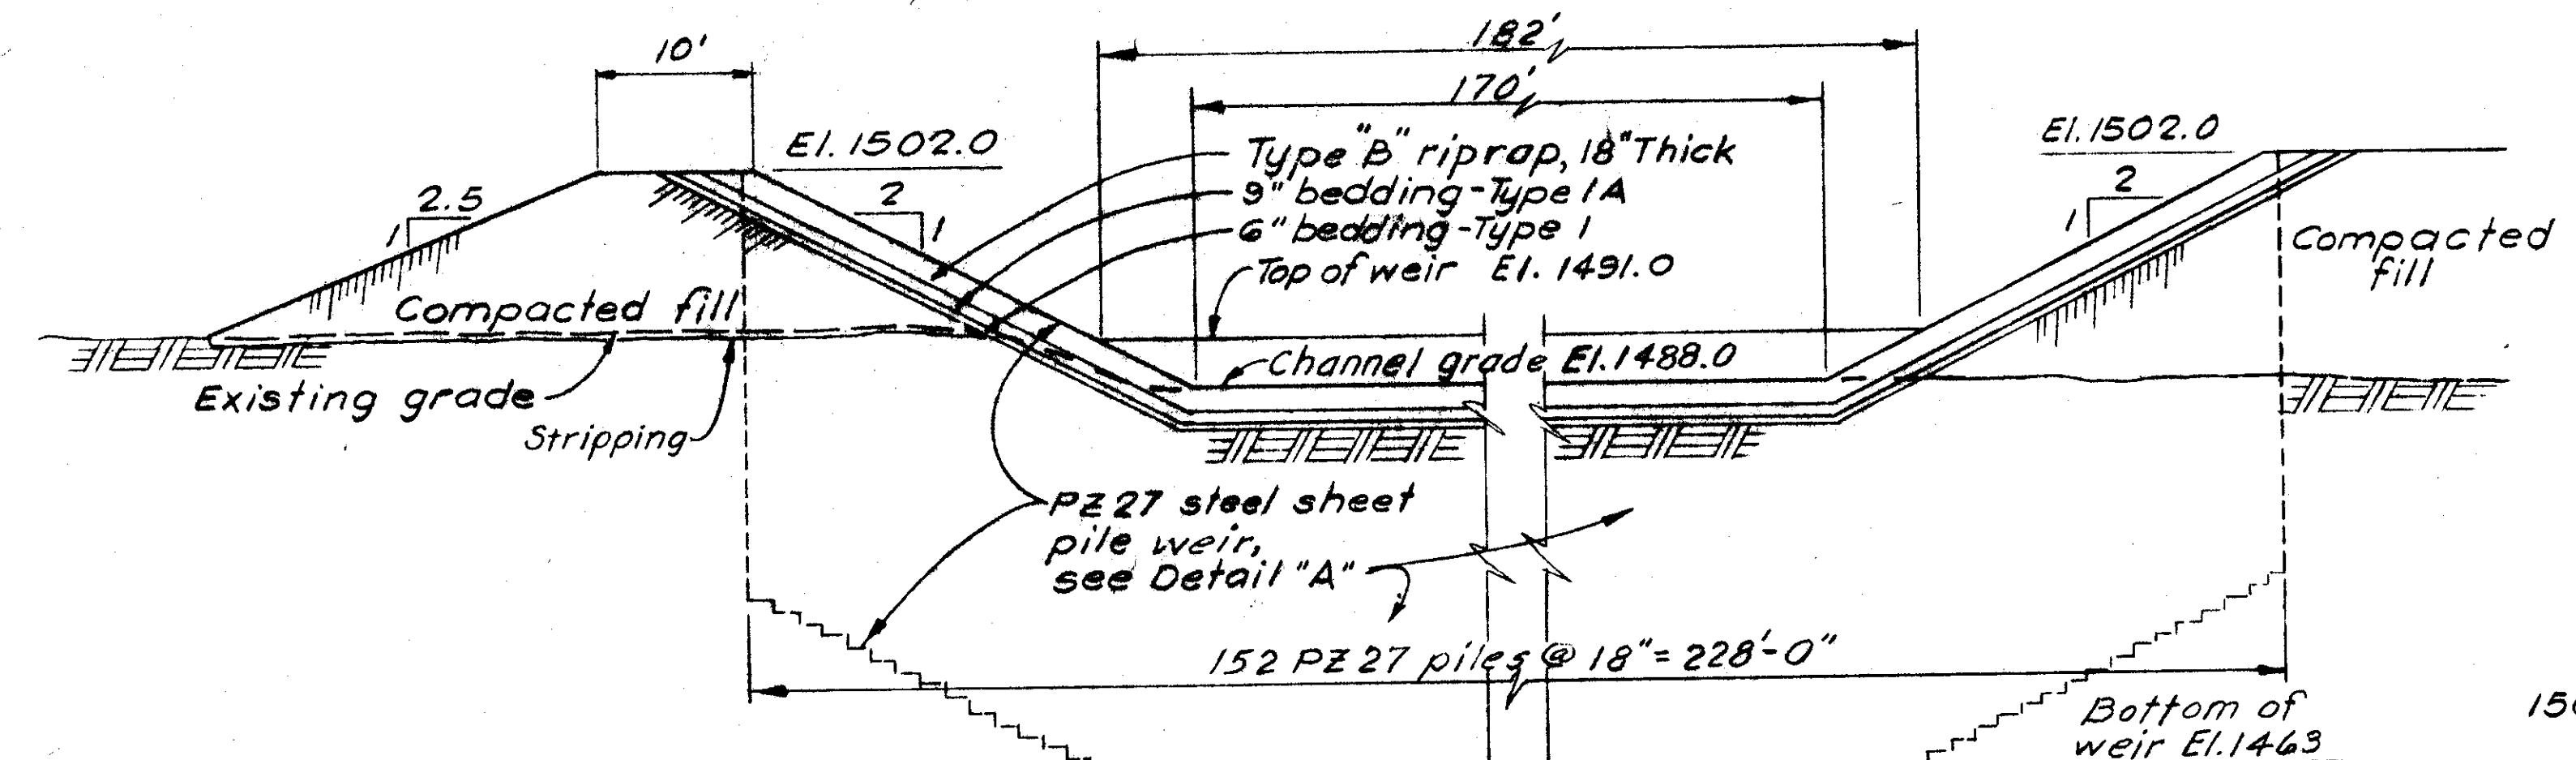


SECTION H-H
SCALE: 1"=10'

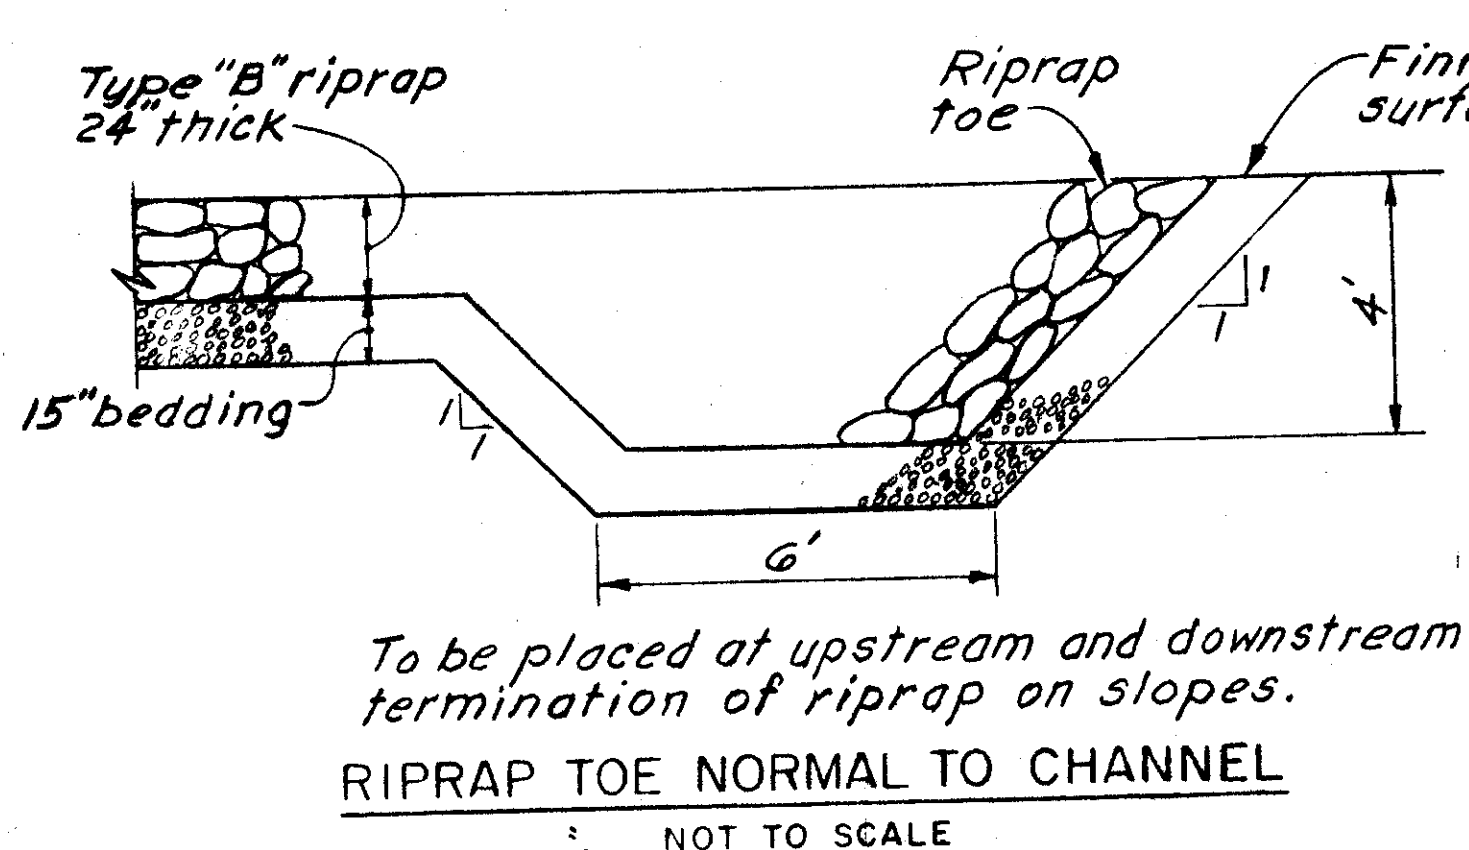

SECTION L-L
SCALE: 1"=10'





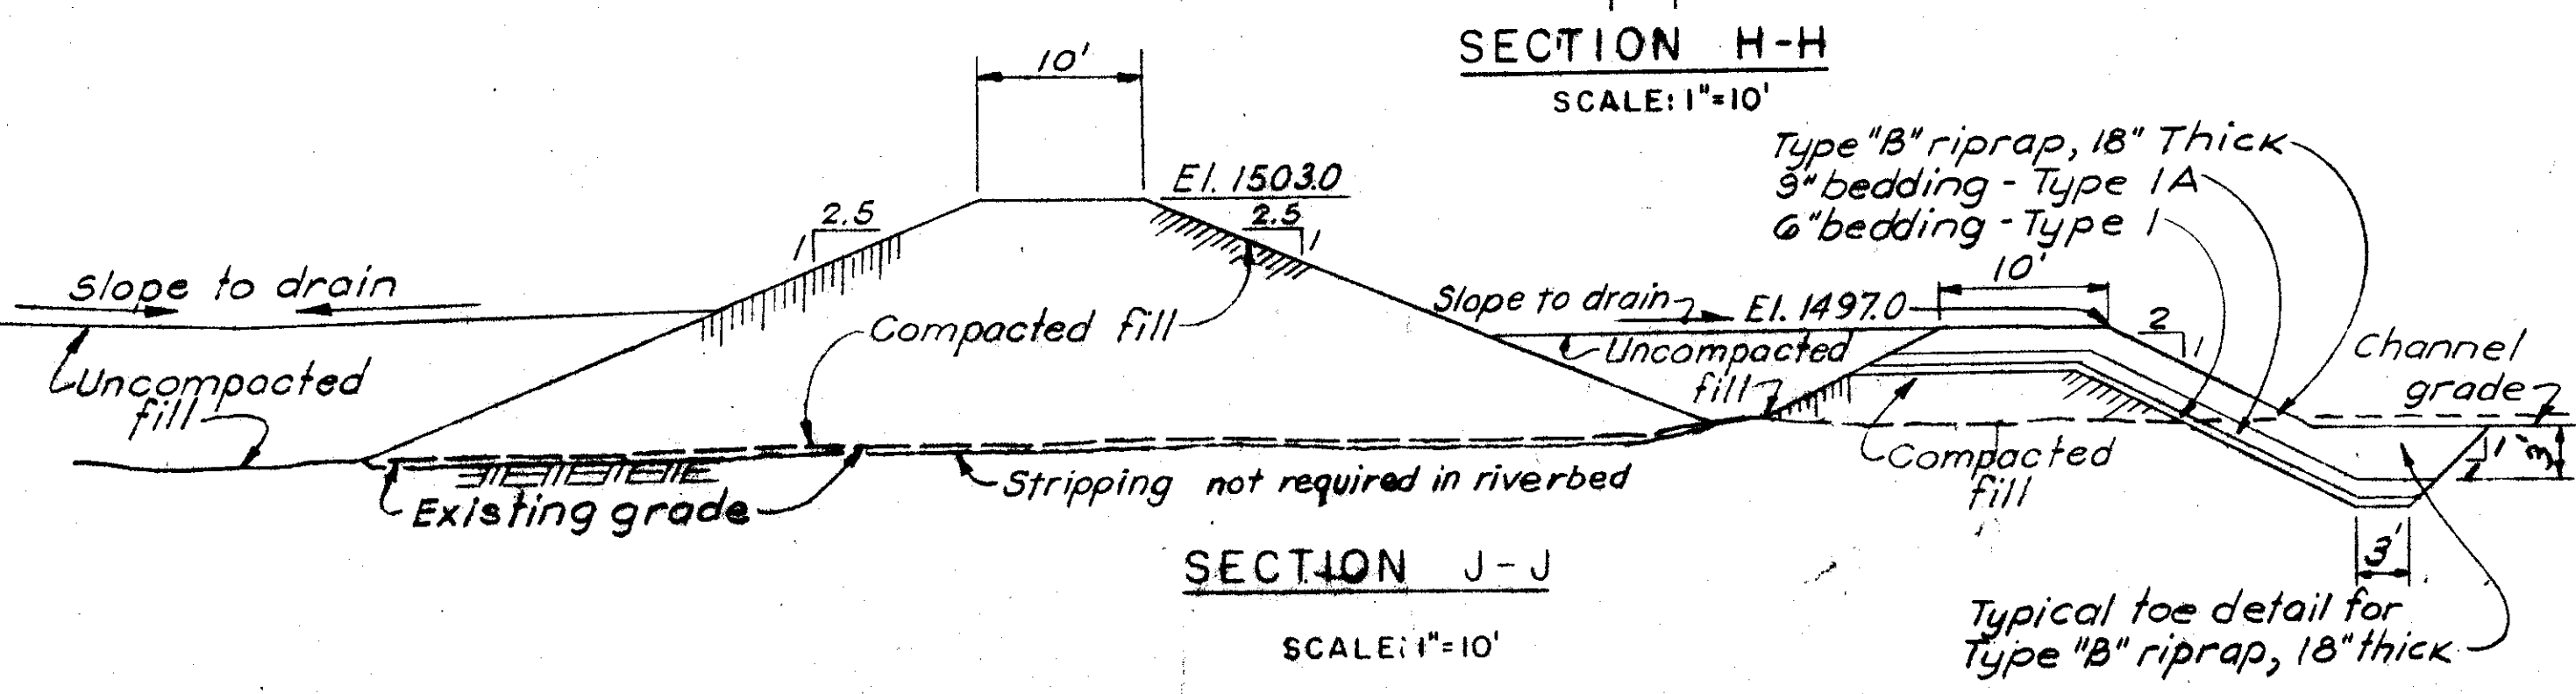


SECTION J-J
SCALE: 1"=10'

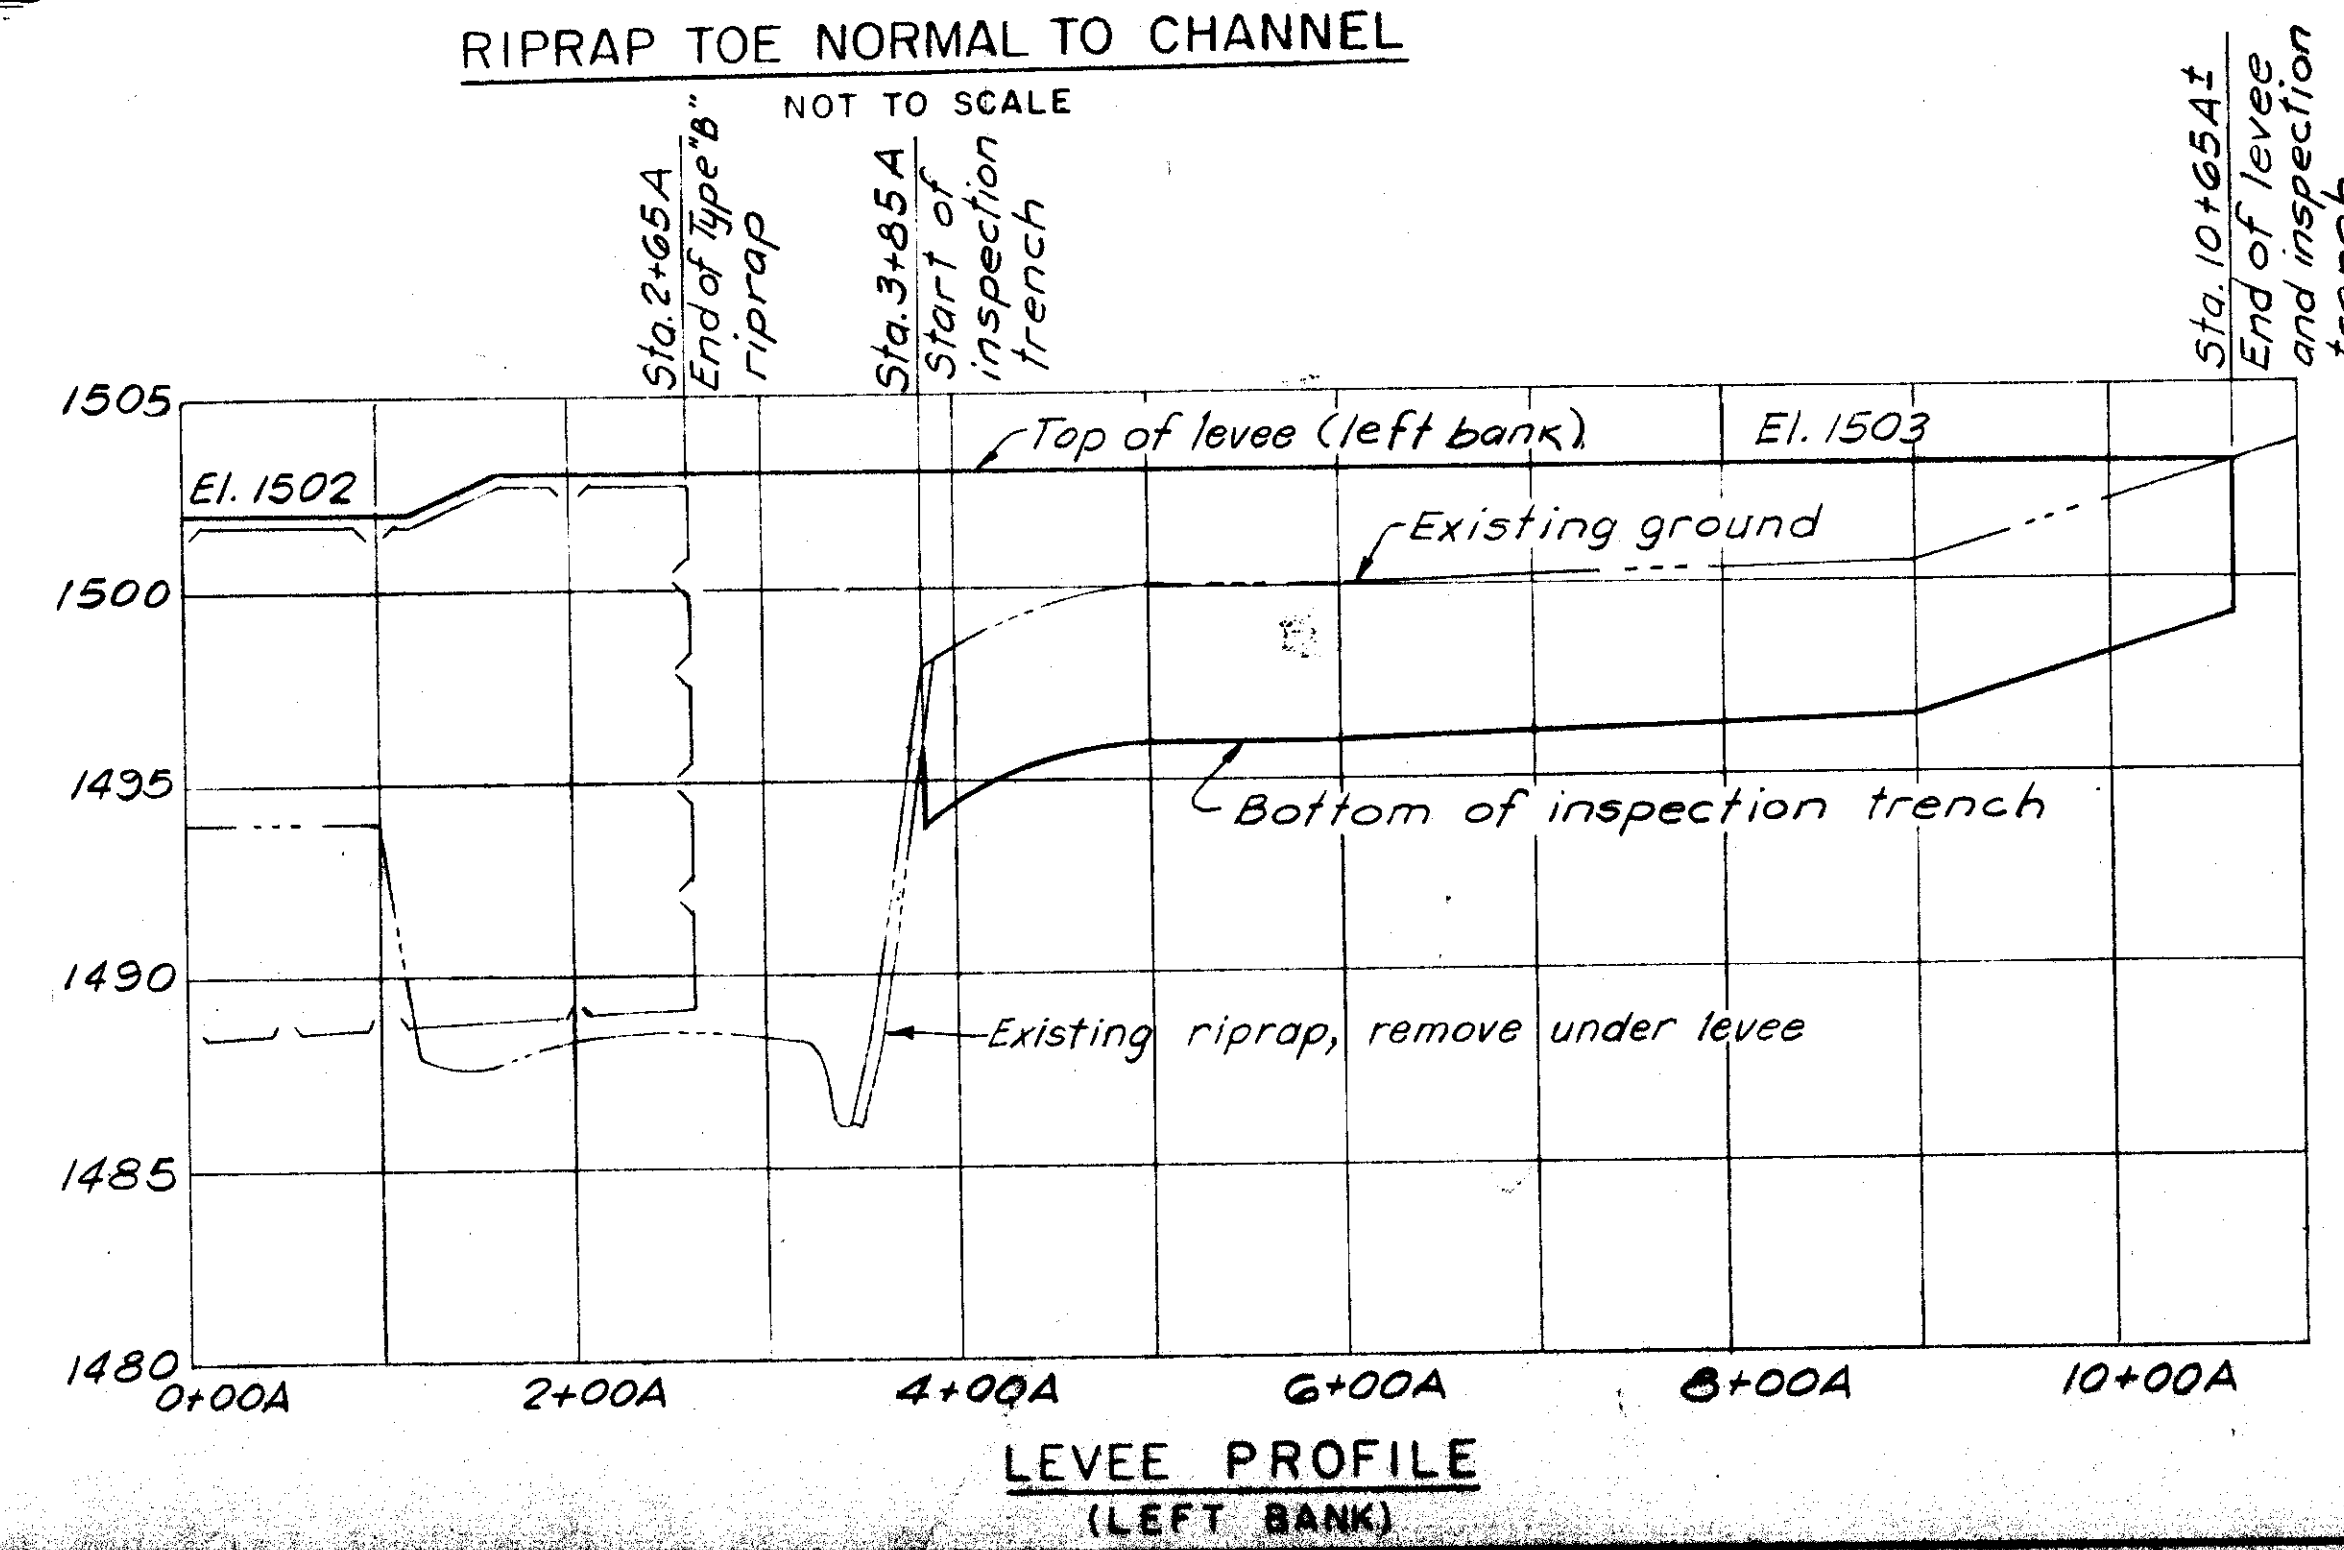

LEVEE PROFILE
(LEFT BANK)

AS CONSTRUCTED											
SUBMITTED:		APPROVED:									
CHIEF CONSTRUCTION-OPERATIONS DIVISION		COL. C. E. DISTRICT ENGINEER									
NOTES:											
1. Dimensions of the precast concrete blocks shall be determined by the contractor in accordance with the specifications.											
2. Concrete shall reach 1500 p.s.i. strength before precast concrete blocks are lifted. A plate shall be used under the eyebolt with the eyebolt screwed down tight for handling. Eyeballs and plates shall remain the property of the contractor.											
<table border="1"> <thead> <tr> <th>REVISION</th> <th>DATE</th> <th>DESCRIPTION</th> <th>BY</th> </tr> </thead> <tbody> <tr> <td> </td> <td> </td> <td> </td> <td> </td> </tr> </tbody> </table>				REVISION	DATE	DESCRIPTION	BY				
REVISION	DATE	DESCRIPTION	BY								
U. S. ARMY ENGINEER DISTRICT, BUFFALO CORPS OF ENGINEERS BUFFALO, NEW YORK 14207											
LOCAL FLOOD PROTECTION WELLSVILLE, NEW YORK GENESEE RIVER SECTIONS AND DETAILS											
DRAWN BY: W. F. S. DESIGNED BY: V. M. CHECKED BY: E. J. G. SUBMITTED BY:		APPROVAL RECOMMENDED: CHIEF, ENGINEERING DIVISION									
TO ACCOMPANY SPECIFICATIONS SERIAL NO. DACW 49 76 B 0018		DRAWING NUMBER 76-WEL-1/4 SHEET 4 OF 5									

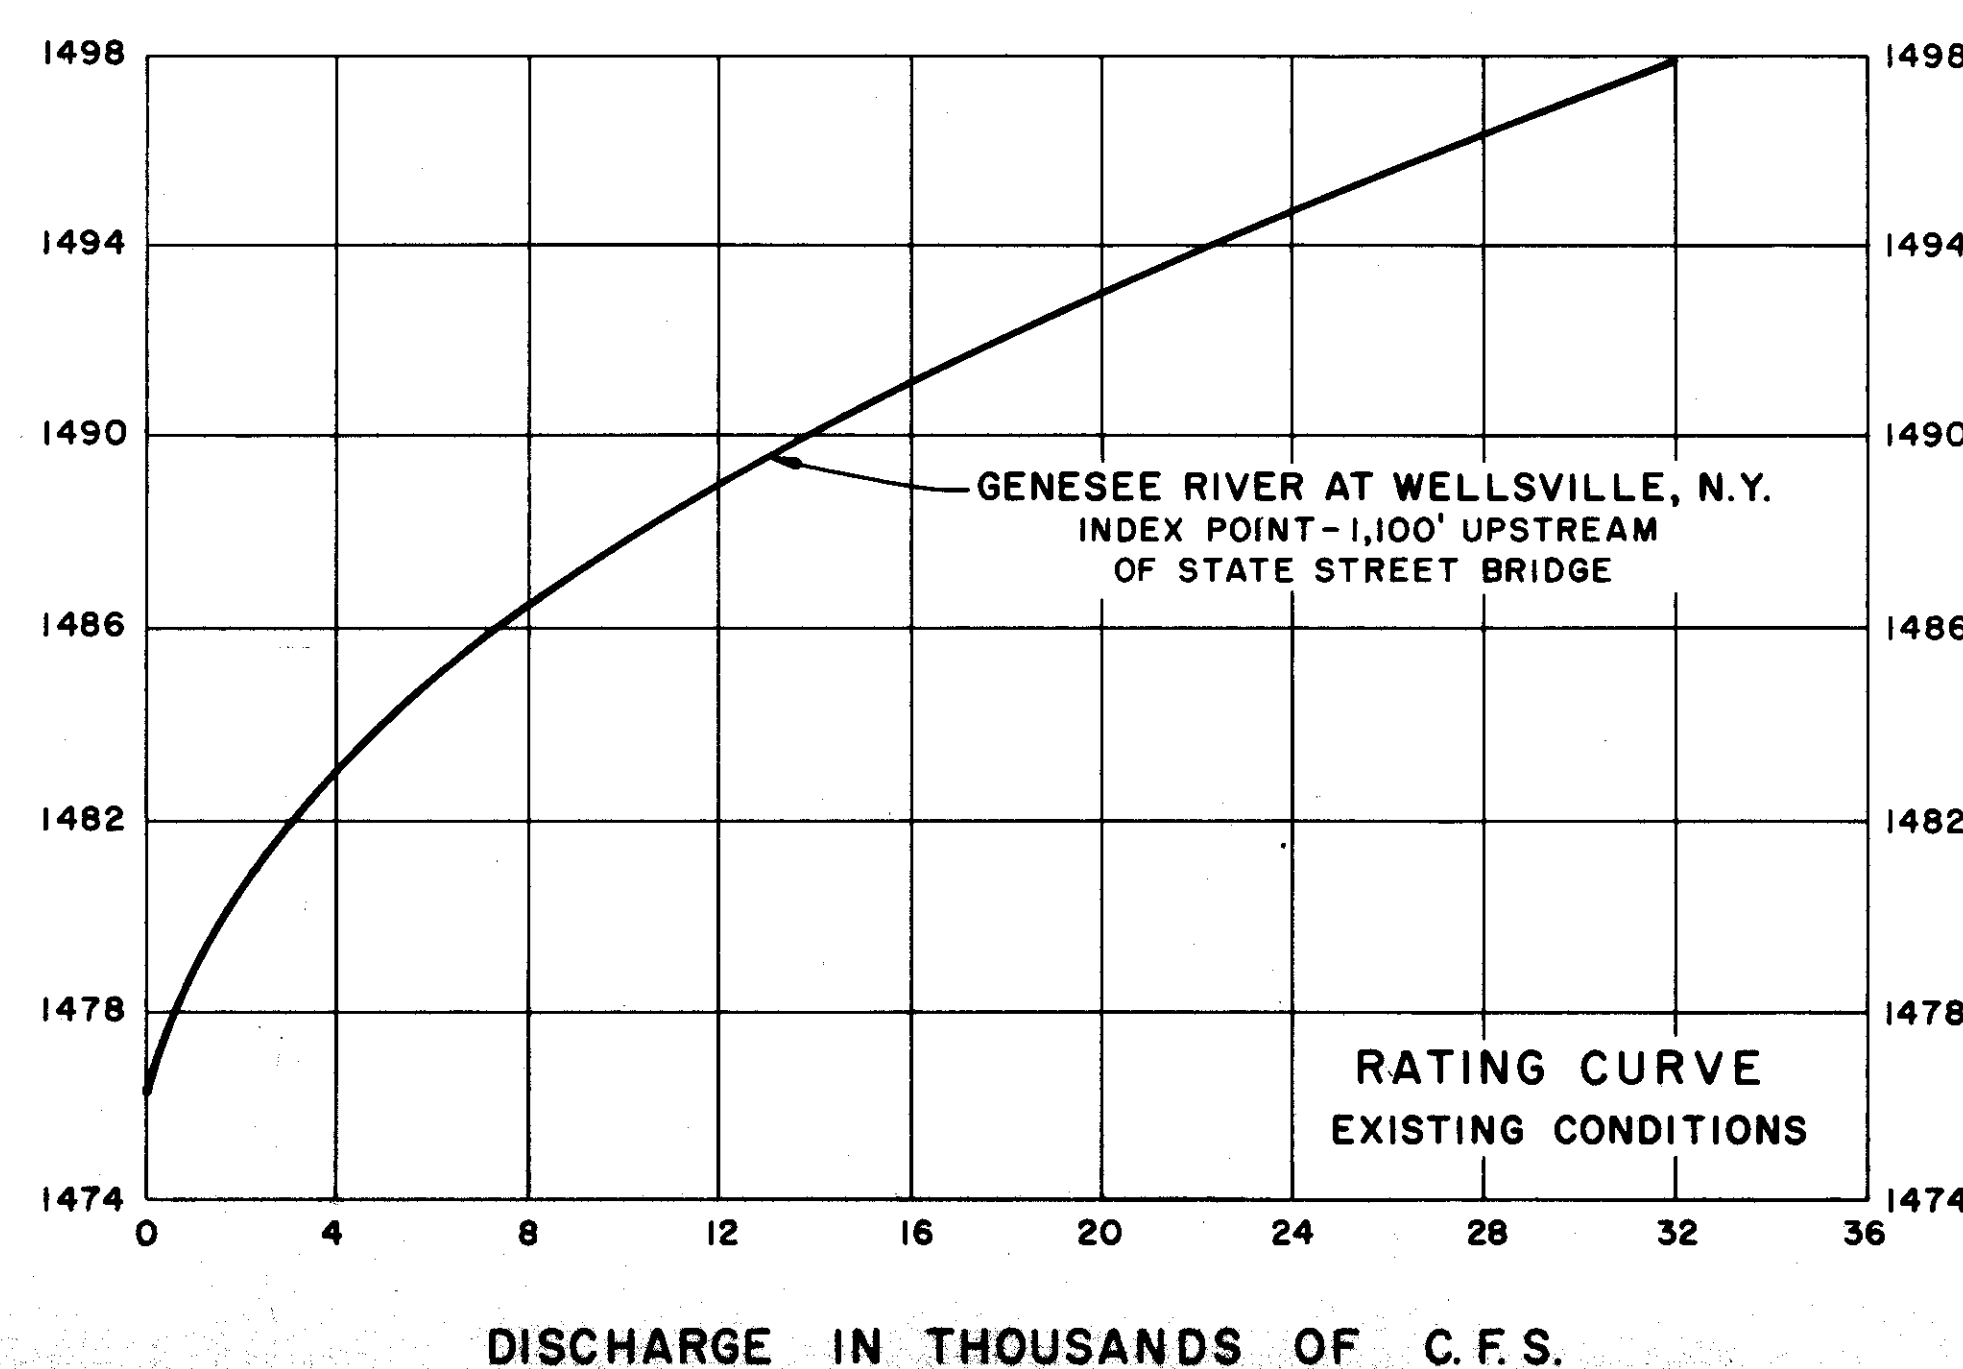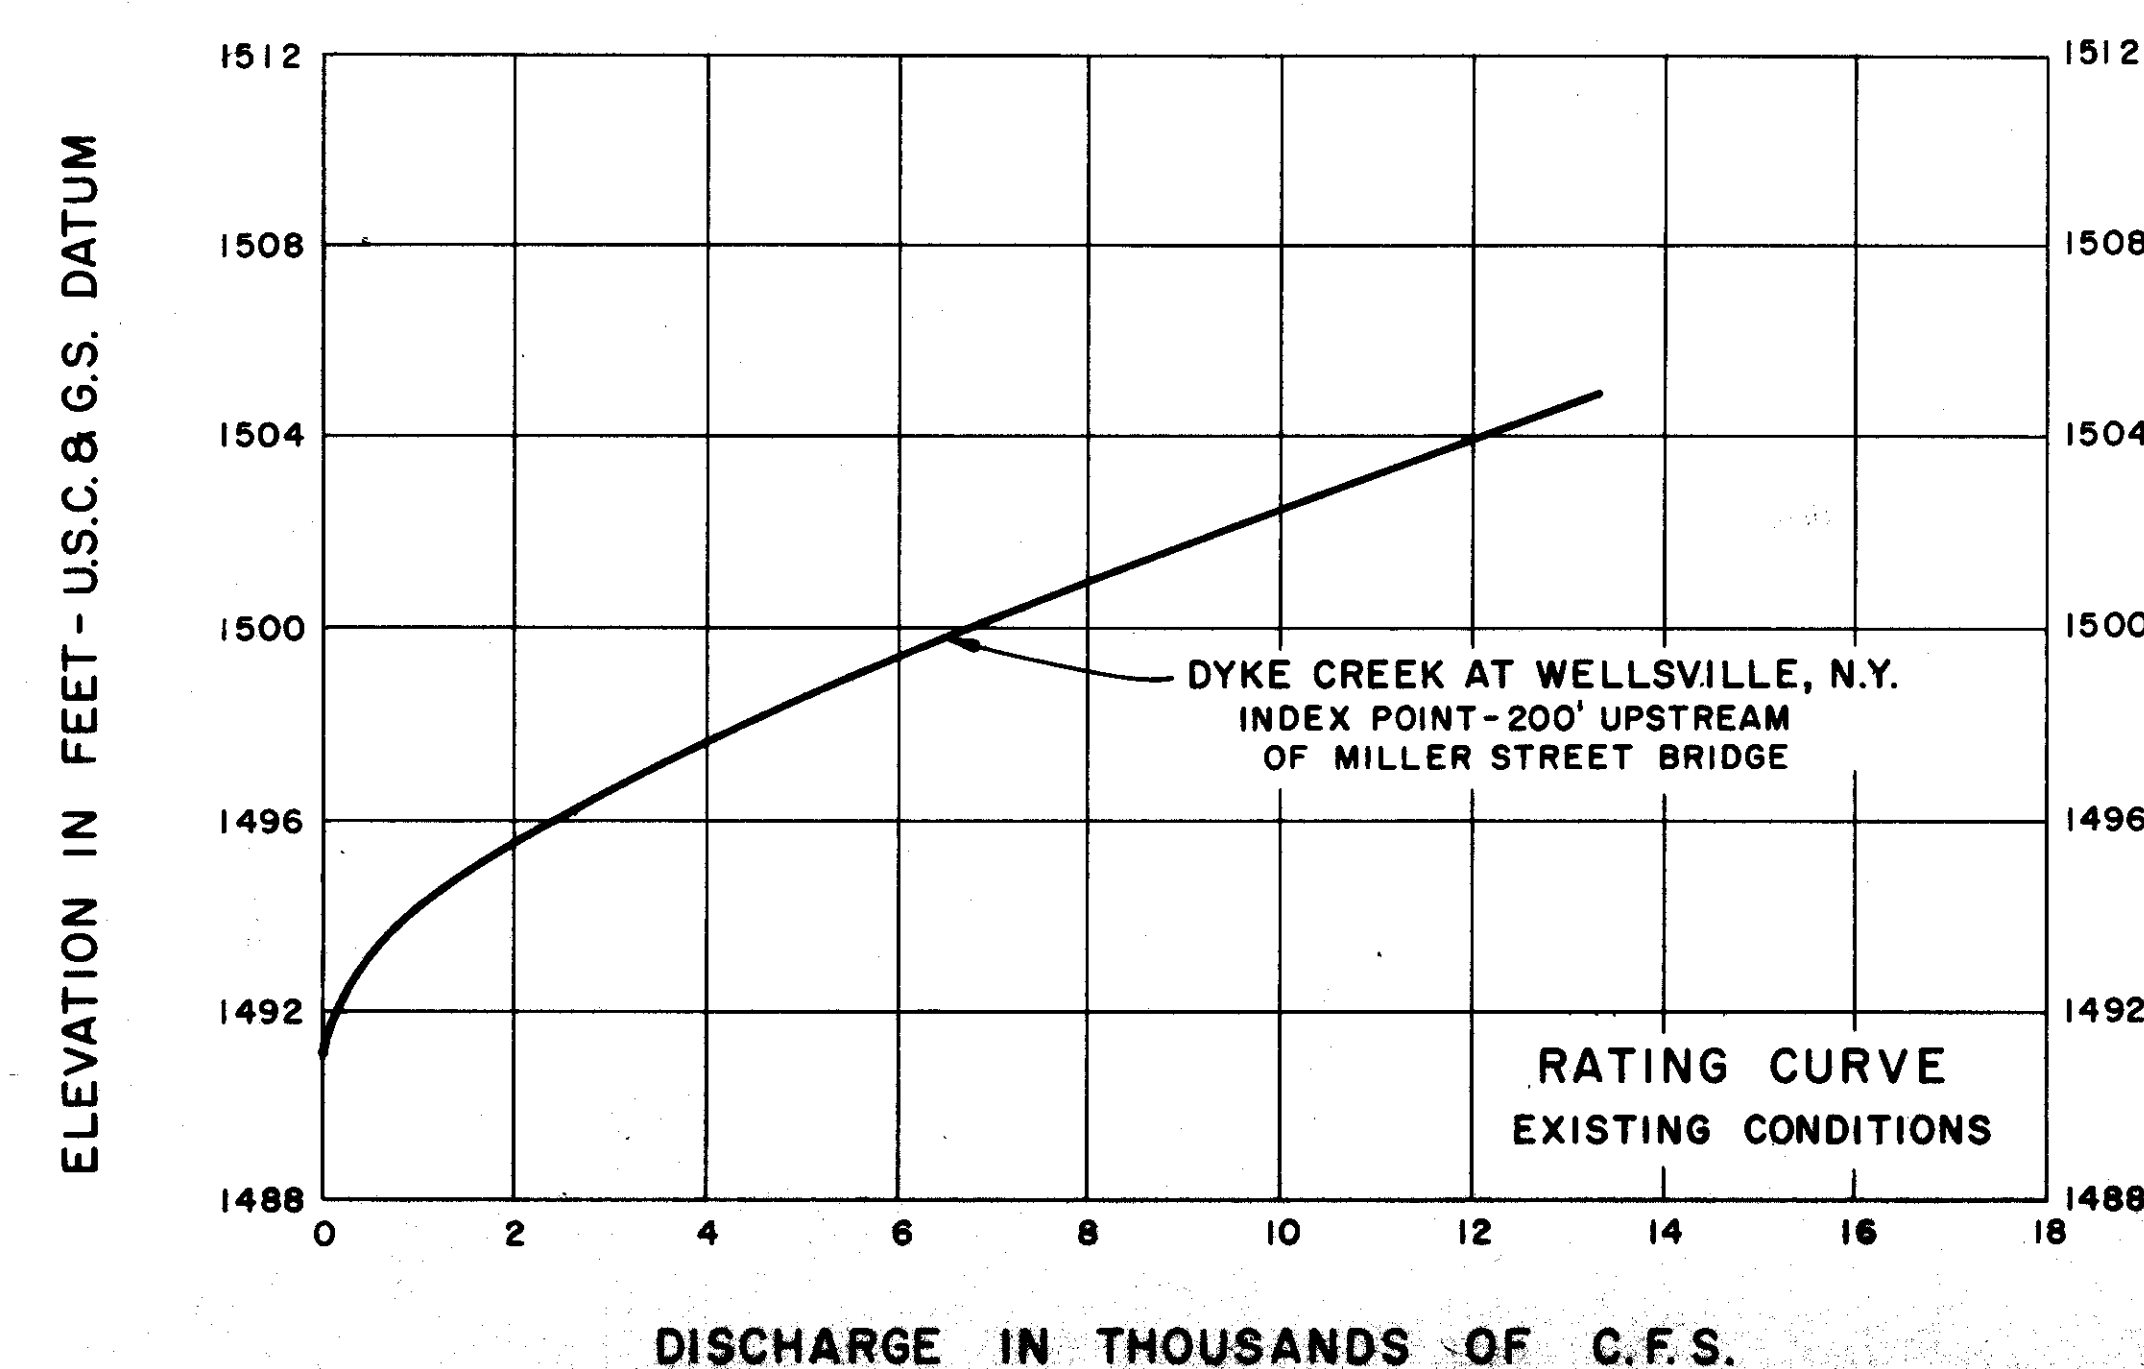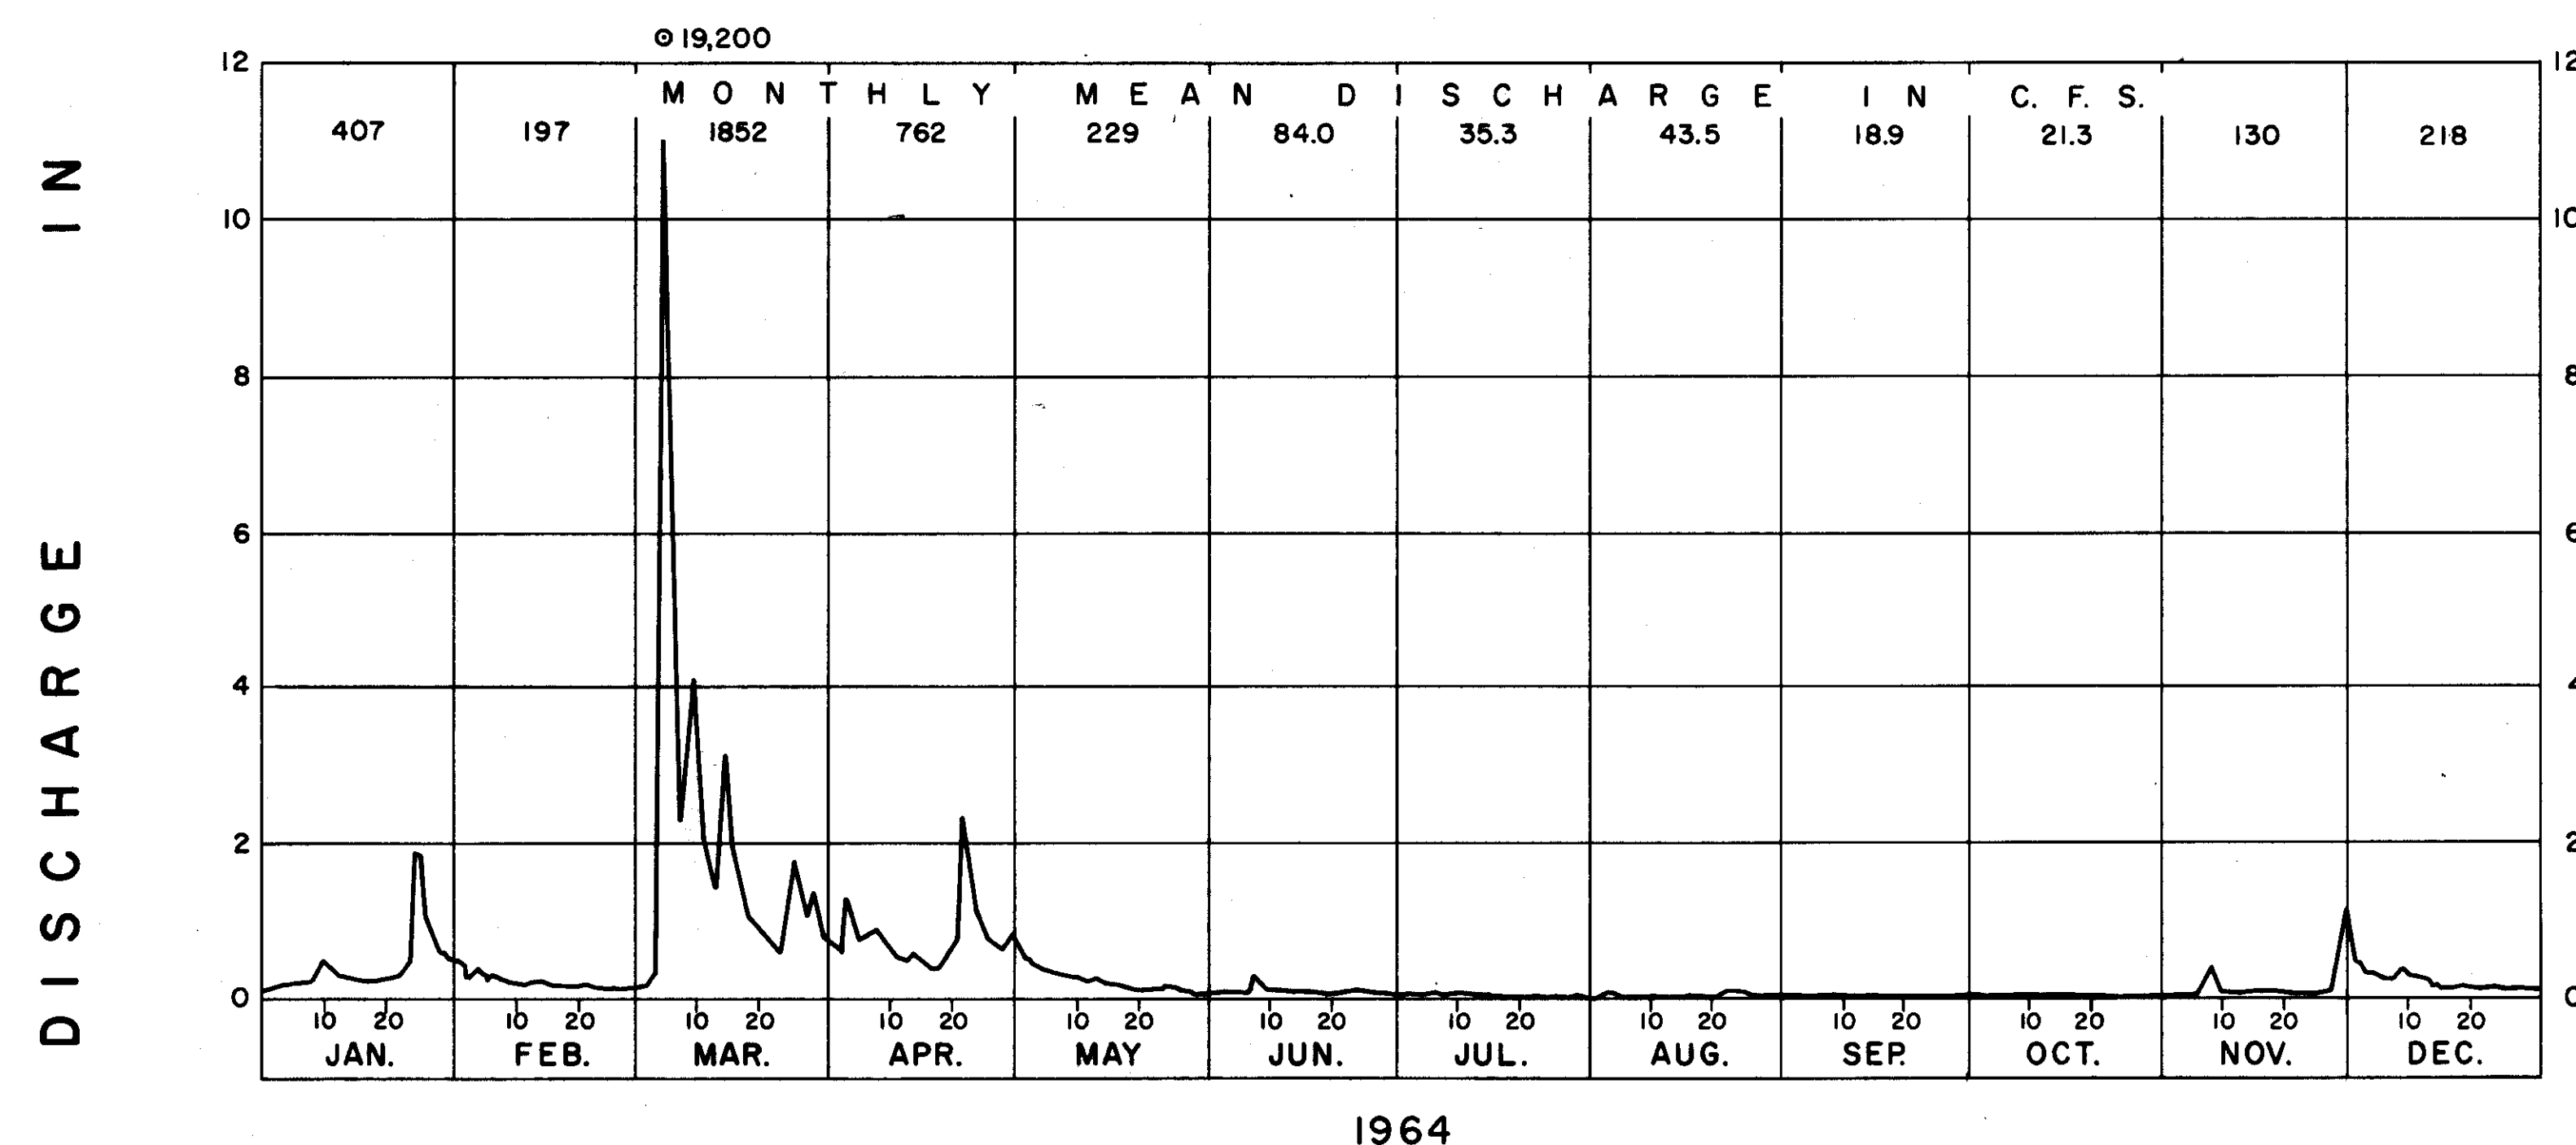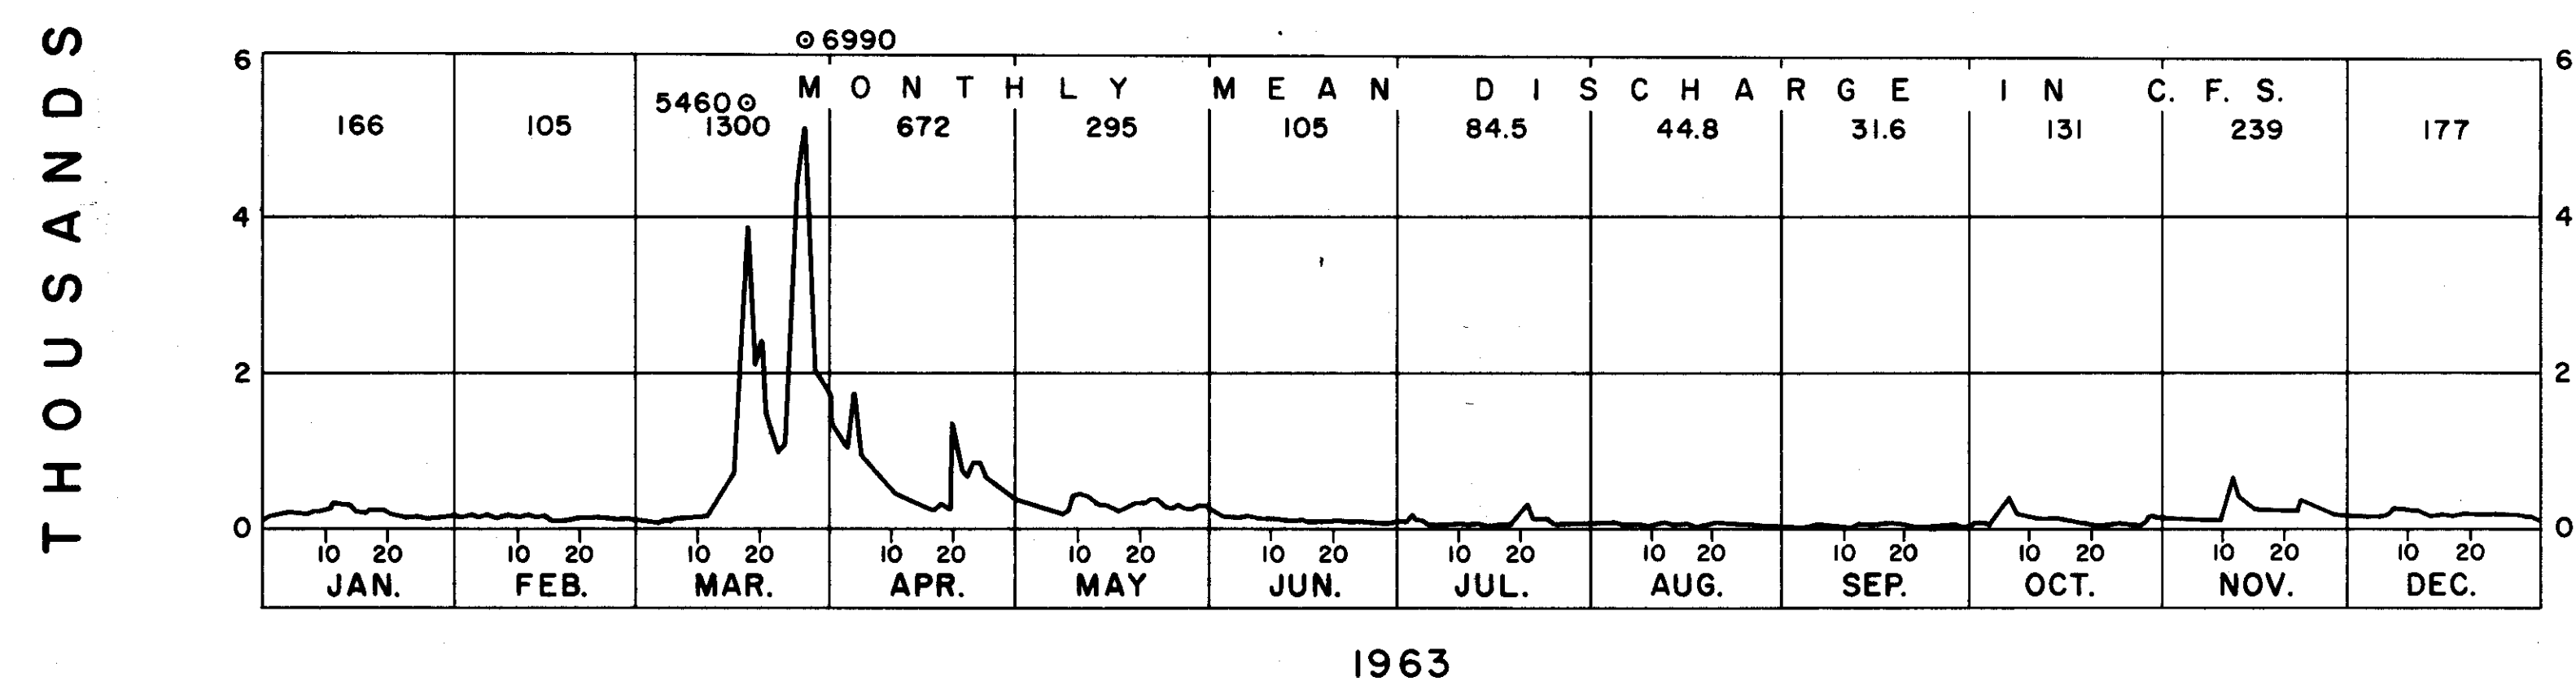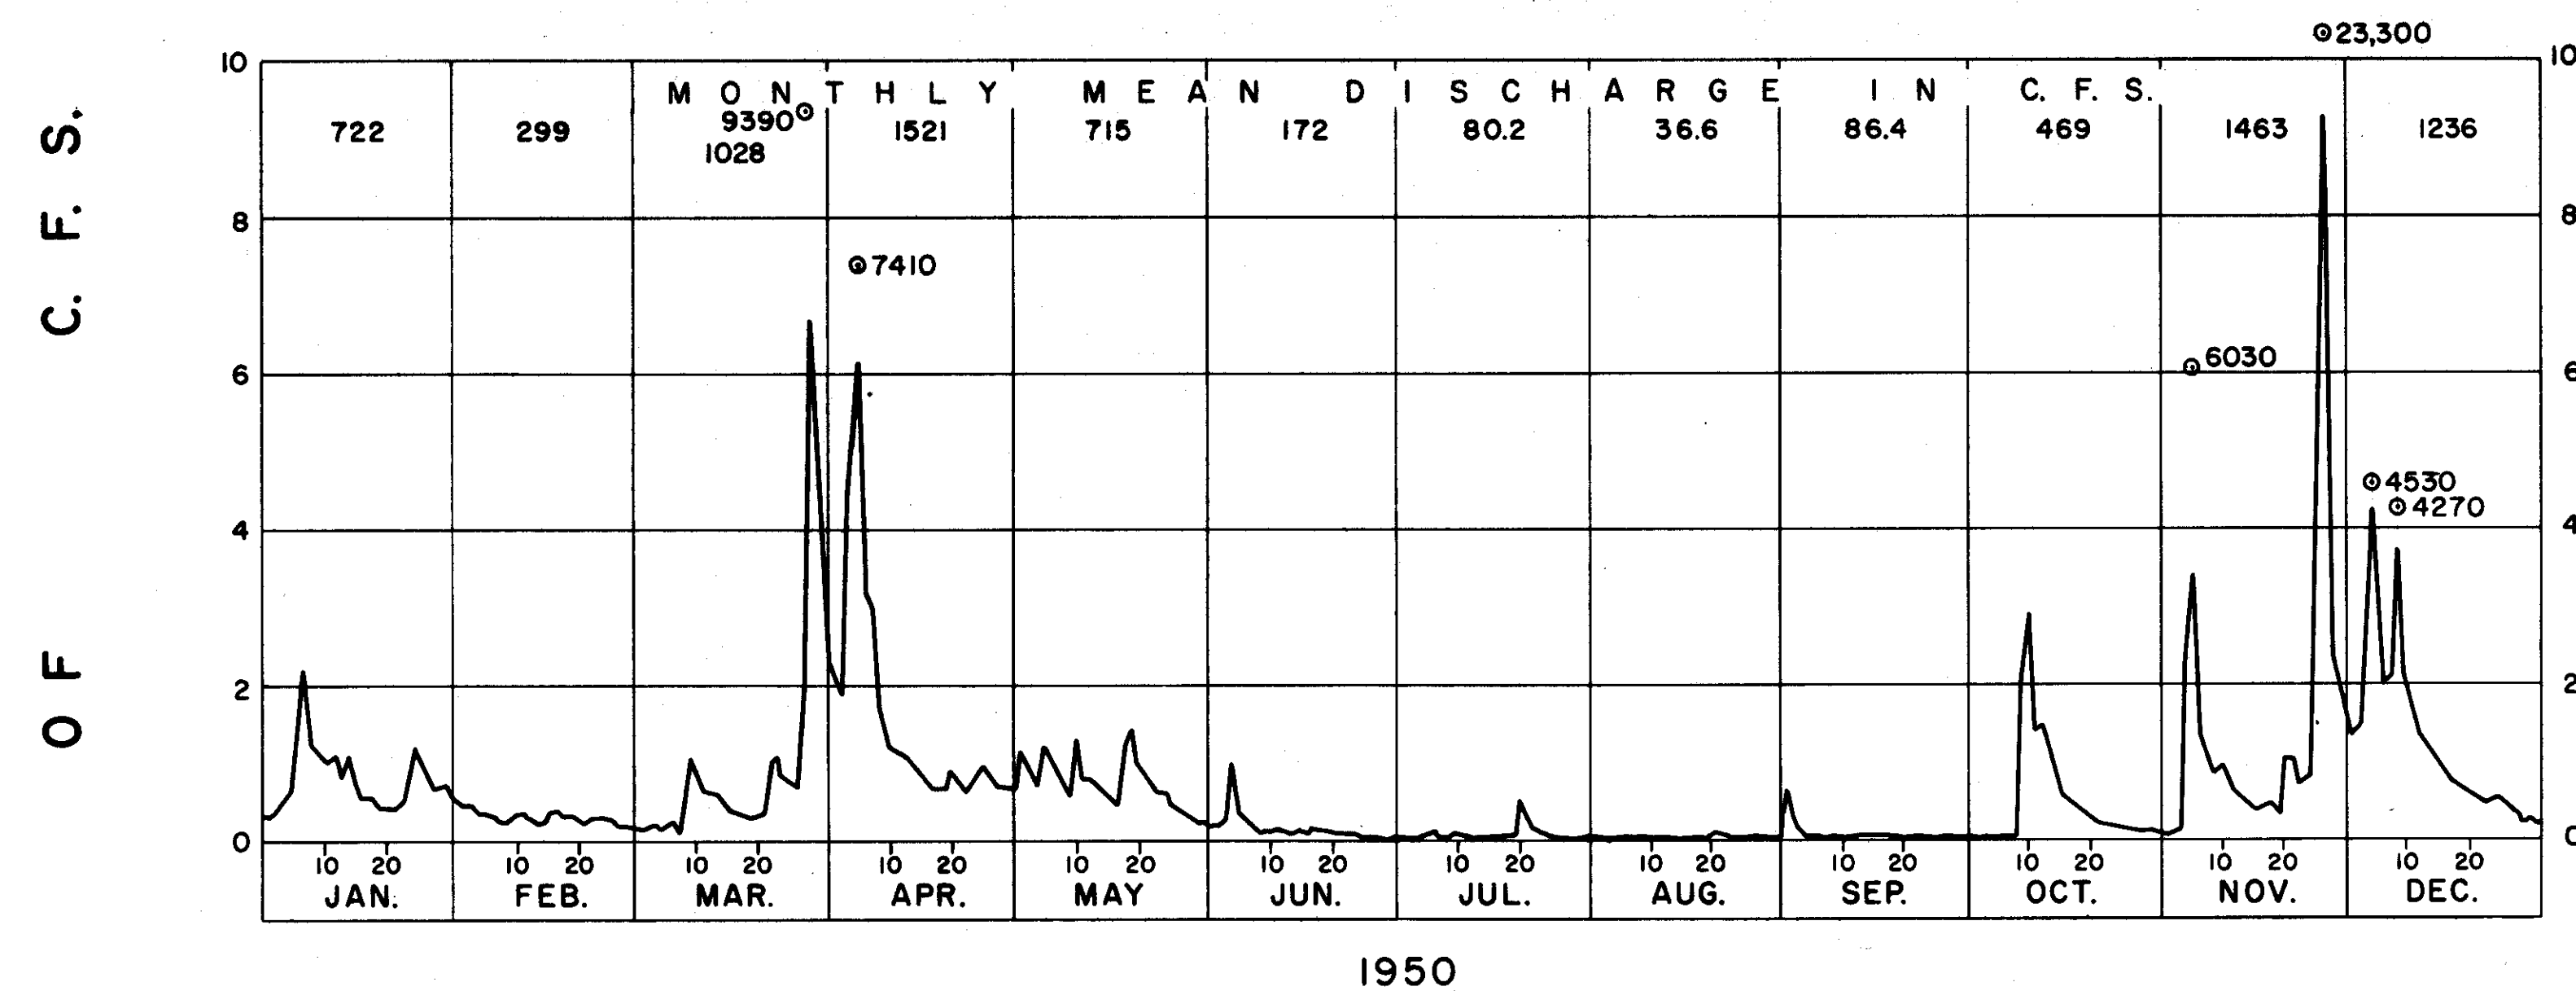

ELEVATION IN FEET - U.S.C. & G.S. DATUM

AS CONSTRUCTED

SUBMITTED: *[Signature]* APPROVED: *[Signature]*
CHIEF CONSTRUCTION-OPERATIONS DIVISION COL., C.E. DISTRICT ENGINEER

NOTES:

- DISCHARGE MEASURED AT GAGE LOCATED ON LEFT BANK 0.4 MILE UPSTREAM FROM VANDERMARK CREEK AND 0.75 MILE UPSTREAM FROM SCIO, ALLEGANY COUNTY, NEW YORK.
- DRAINAGE AREAS:
1. GENESEE RIVER AT SCIO EQUALS 309 SQ. MILES.
 2. GENESEE RIVER AT WELLSVILLE EQUALS 288 SQ. MILES.
 3. GENESEE RIVER ABOVE CONFLUENCE OF DYKE CREEK EQUALS 216 SQ. MILES.
 4. DYKE CREEK AT CONFLUENCE WITH GENESEE RIVER EQUALS 72 SQ. MILES.

LEGEND:

23,300---INSTANTANEOUS MAXIMUM DISCHARGE IN C.F.S.
C.F.S.---CUBIC FEET PER SECOND

REVISION	DATE	DESCRIPTION	BY

U.S. ARMY ENGINEER DISTRICT, BUFFALO
CORPS OF ENGINEERS
BUFFALO, NEW YORK 14207

DRAWN BY: *J. J. N.*
DESIGNED BY:
CHECKED BY:
SUBMITTED BY:
APPROVAL RECOMMENDED: *[Signature]*
TO ACCOMPANY SPECIFICATIONS SERIAL NO. DACW 49 76 8 0015

LOCAL FLOOD PROTECTION
WELLSVILLE, NEW YORK
GENESEE RIVER
HYDROGRAPHS AND RATING CURVES
DATE: *21 Jan 76*
DRAWING NUMBER
76-WEL-1/5
SHEET 5 OF 5