
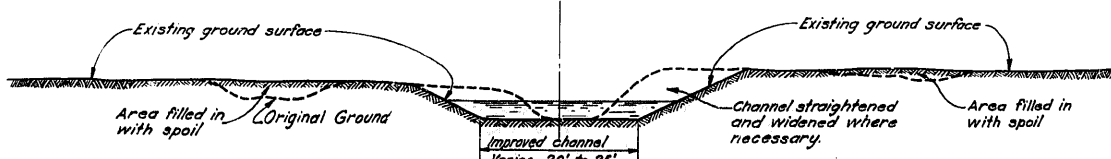
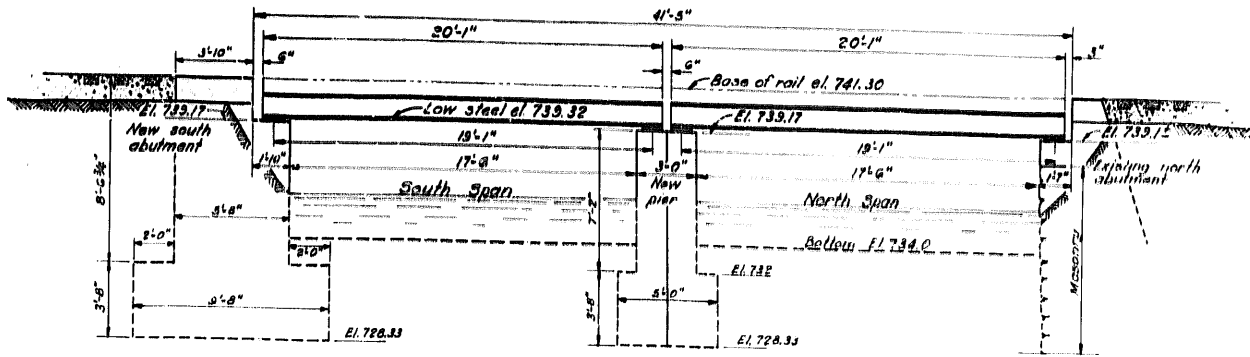


TITLE	SHEET NO.	FILE NO.
MORAVIA,OWASCO INLET,NEW YORK		
INDEX MAP,AS BUILT DRAWINGS	1	E-234-A-11/1
MILL CREEK,PLAN & SECTIONS	2	do /2
MILL CREEK,PLAN & SECTIONS	3	do /3
MILL CREEK,PLAN & SECTIONS	4	do /4
MILL CREEK,PLAN & SECTIONS	5	do /5
MILL CREEK,PLAN & SECTIONS	6	do /6
MILL CREEK, PROFILES	7	do /7
DRY CREEK , PLAN & SECTIONS	8	do /8
DRY CREEK , PLAN & SECTIONS	9	do /9
OWASCO INLET, PLANS & SECTIONS	10	do /10

This drawing is reduced to
38% of the original scale.

DEPARTMENT OF THE ARMY CORPS OF ENGINEERS OFFICE OF THE DISTRICT ENGINEER BUFFALO 7, NEW YORK	
DRAWN BY: R.D.R.	MORAVIA,OWASCO INLET, NEW YORK INDEX MAP OF AS BUILT DRAWINGS
TRACED BY: R.D.R.	
CHECKED BY: H.A.J.	
SUBMITTED BY: <i>James H. Schuchman</i>	
APPROVED: <i>James H. Schuchman</i>	
DATE: October 29, 1948	SCALE: AS SHOWN
DRAWING NUMBER E-234-A-11/1	SHEET 1 OF 10

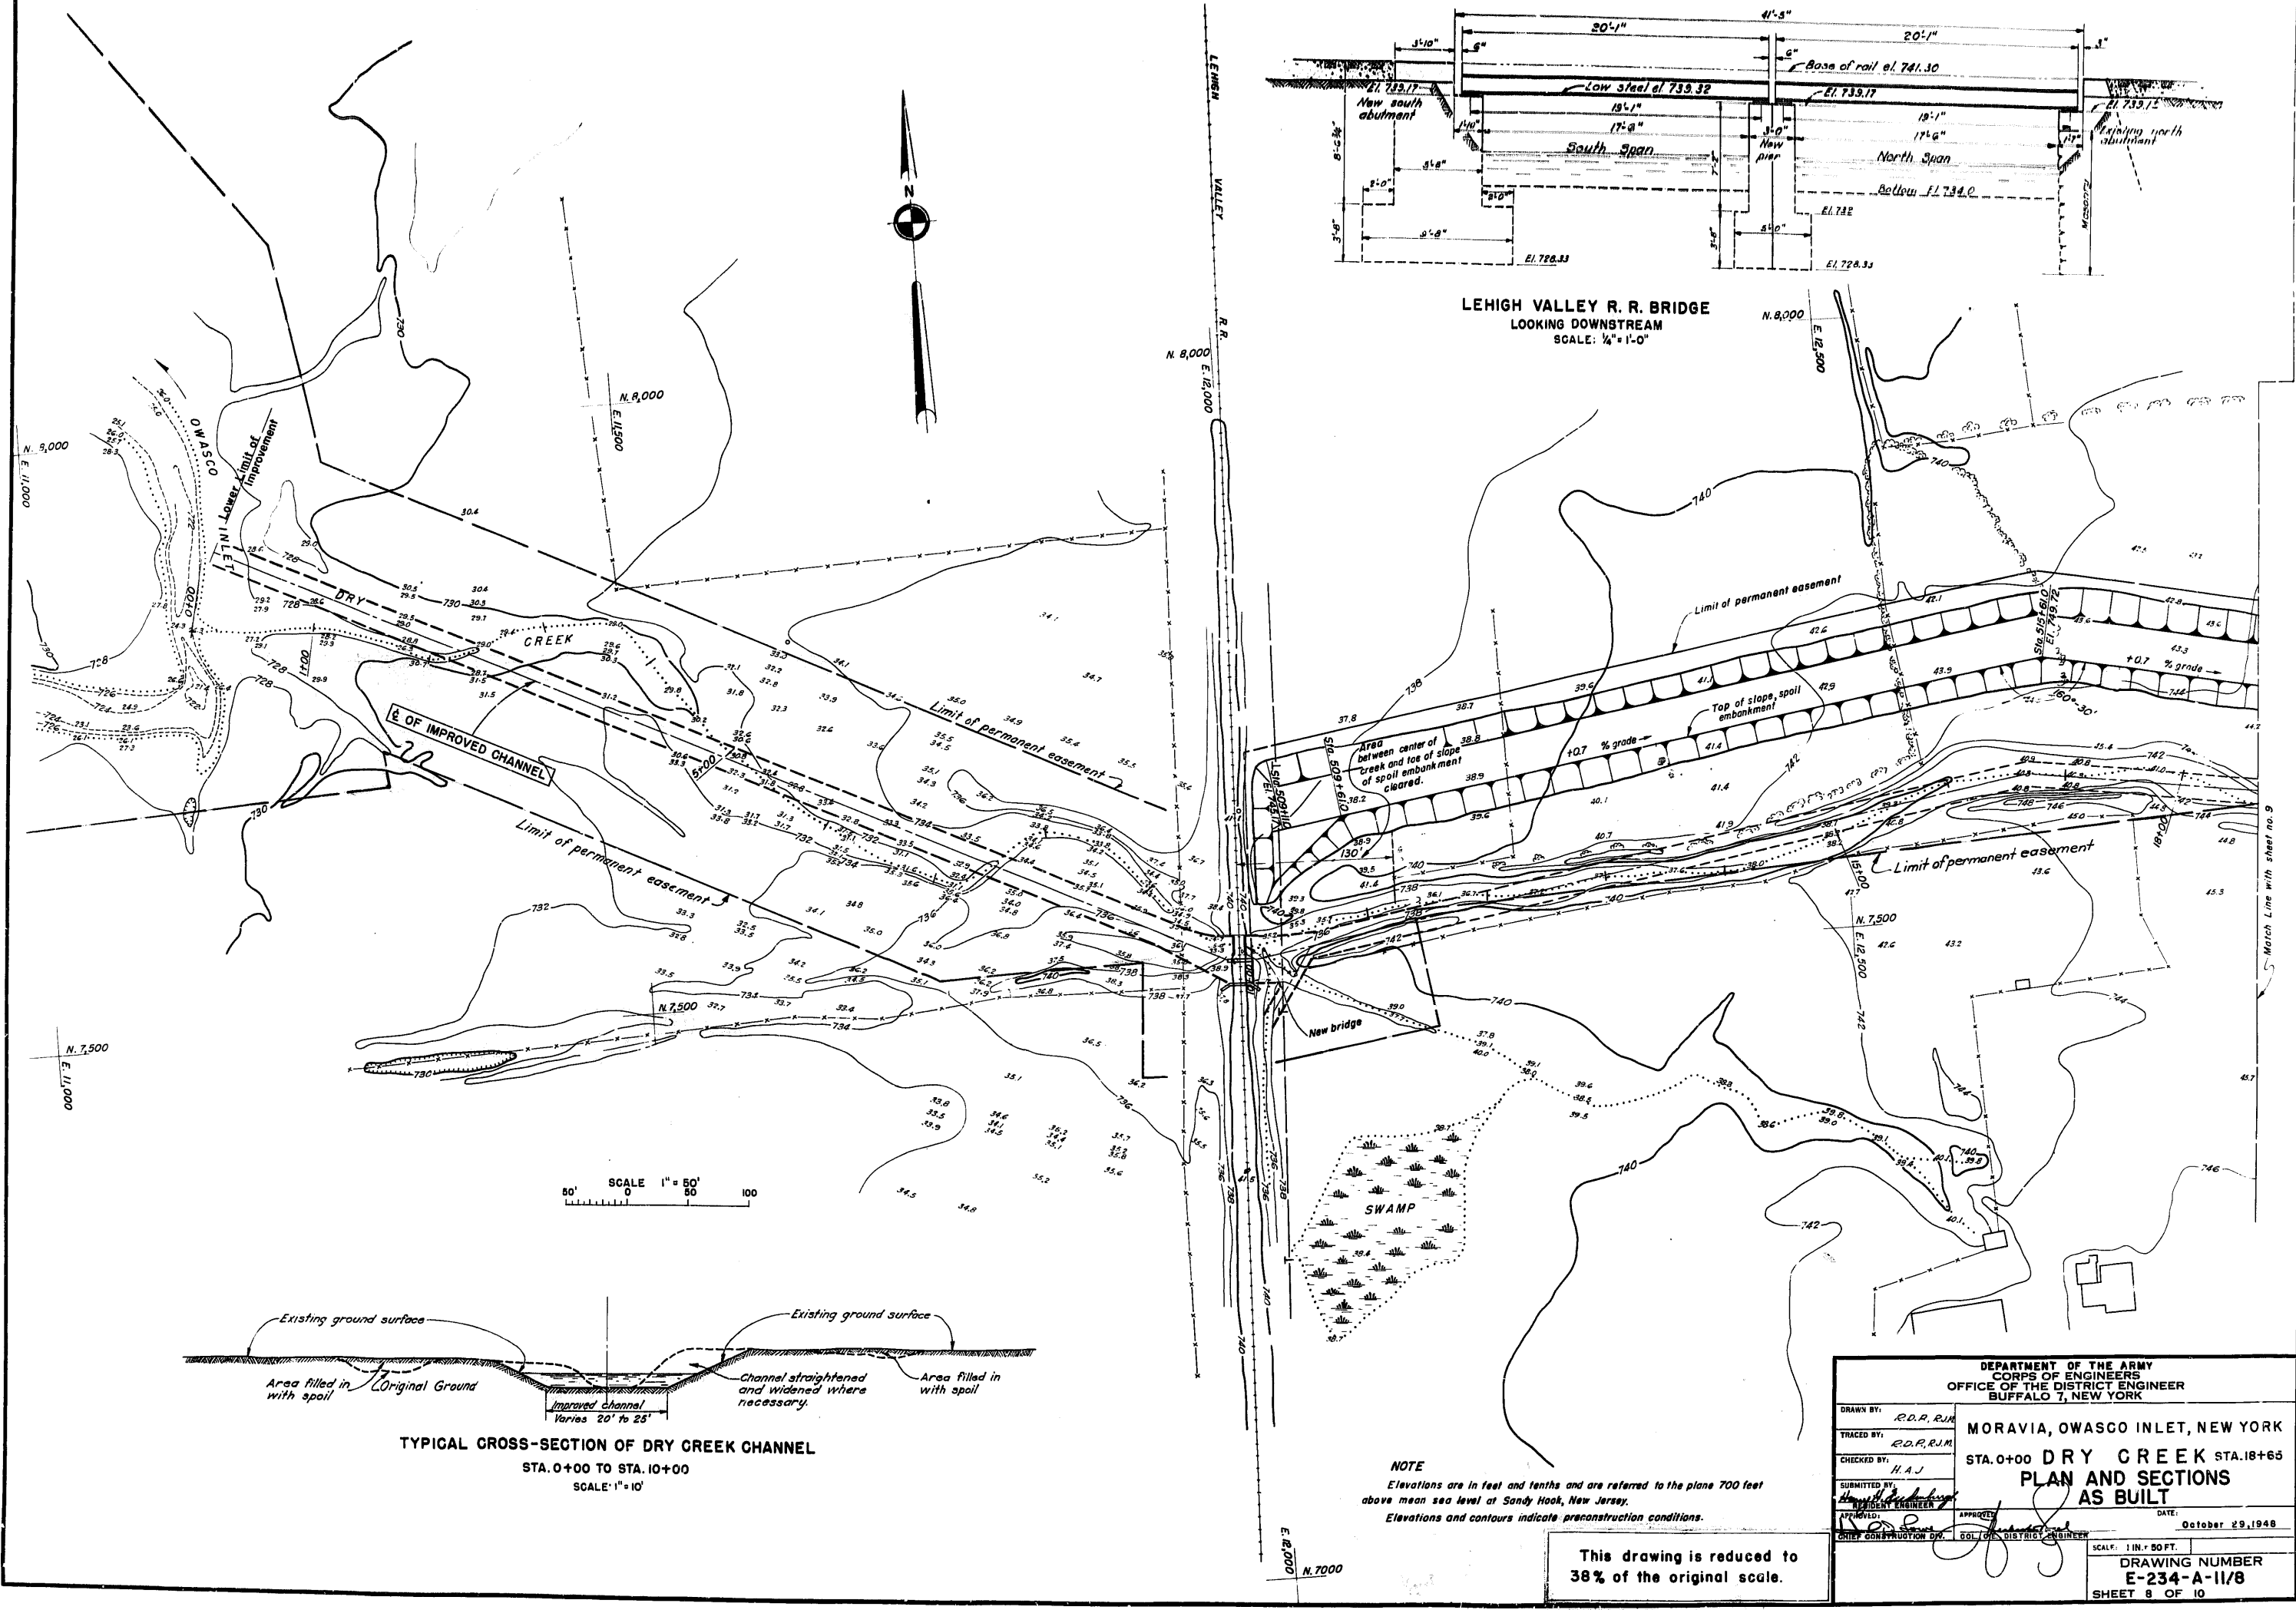


NOTE
Elevations are in feet and tenths and are referred to the plane 700 feet above mean sea level at Sandy Hook, New Jersey.
Elevations and contours indicate preconstruction conditions.

This drawing is reduced to 38% of the original scale.



DEPARTMENT OF THE ARMY CORPS OF ENGINEERS OFFICE OF THE DISTRICT ENGINEER BUFFALO 7, NEW YORK	
MORAVIA, OWASCO INLET, NEW YORK	
STA. 0+00 DRY CREEK STA. 18+65	
PLAN AND SECTIONS AS BUILT	
DATE: October 29, 1948	
SCALE: 1 IN. = 50 FT.	
DRAWING NUMBER E-234-A-11/8	
SHEET 8 OF 10	

Drawn by: R.D.P.R.M.
Traced by: R.D.P.R.M.
Checked by: H.A.J.
Submitted by: [Signature]
Reviewed by: [Signature]
Chief Construction Div. [Signature]
District Engineer [Signature]

LEVEE CROSS-SECTION A-A
Scale: 1 inch = 10 Feet

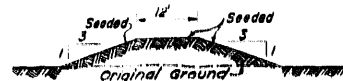

TYPICAL CROSS-SECTION OF DRY CREEK
STA. 10+00 TO STA. 31+00
SCALE 1"=10'

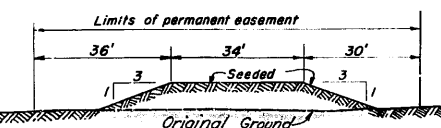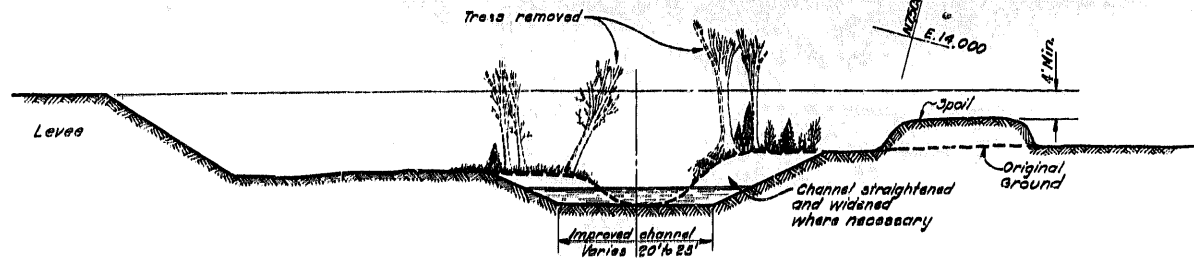

TYPICAL SECTION OF SPOIL EMBANKMENT
STATION 10+00 TO ROUTE NO. 33
Scale: 1 inch = 10 Feet

N. 8,000
E. 13,000

SCALE 1" = 50'
50' 0 50' 100'

Match Line with sheet no. 8

NOTE -
Elevations are in feet and tenths, and are referred to the plane 700 feet above mean sea level at Sandy Hook, New Jersey.
Elevations and contours indicate preconstruction conditions.

This drawing is reduced to
38% of the original scale.

DEPARTMENT OF THE ARMY CORPS OF ENGINEERS OFFICE OF THE DISTRICT ENGINEER BUFFALO 7, NEW YORK	
DRAWN BY: R.D.P.R.J.M.	MORAVIA, OWASCO INLET, NEW YORK
TRACED BY: R.D.P.R.J.M.	STA. 18+65 DRY CREEK STA. 38+00
CHECKED BY: H.A.J.	PLAN AND SECTIONS AS BUILT
SUBMITTED BY: [Signature]	DATE: October 29, 1948
APPROVED: [Signature]	SCALE: 1 IN. = 50 FT.
DRY CONSTRUCTION DIV.	DRAWING NUMBER E-234-A-11/9 SHEET 9 OF 10